


Section 32 Township 26 Range 6 E

Well No. # 1 Schreiber

Company White & Ellis

NORTH

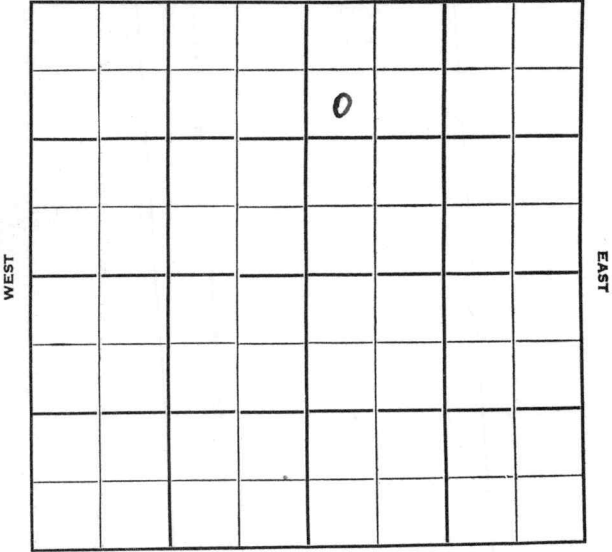

SOUTH

Sec. **32** Twp. **26** R. **6E**

Well No. **#1 Schreiber** Farm

White & Ellis Company

" Contractor


990 Ft. from N. Line

Ft. from S. Line

Ft. from E. Line

330 Ft. from W. Line

SW NW NE

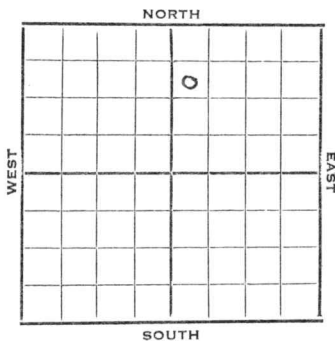

1952 Elev. 1398 **REPORT**

8/27 Location

9/24 Spud 8-30-52
 Oil Well TD 2784
 8" @ 104 Lans. 1840
 KC 2140 Miss 2779
 5" @ 2779 TD 2784
 PB 2780 1500 A P/72 bo 12 hr.
 Comp. 39 bopd 36 bw

COMPLETED

