


Map No. _____ Sec. 32 Twp. 26 R. 6
 Well No. 1 Jellison Farm _____
Lewis Oil Company _____

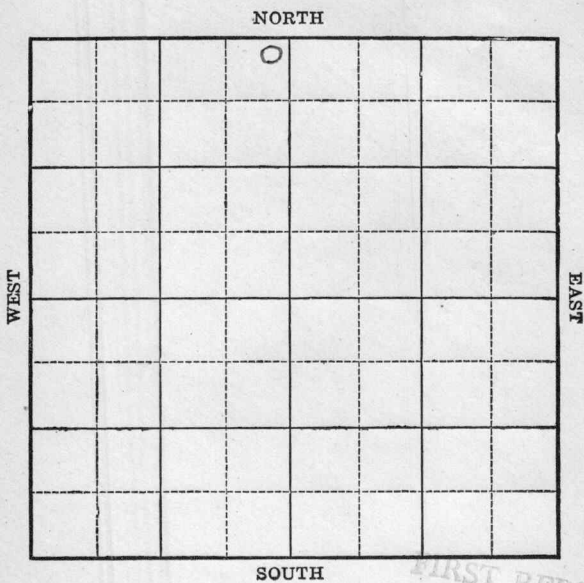

FIRST REPORT

Location _____

Drilling Remarks:

Rig up _____

Drilling Remarks:

RECORD

Cased _____ in. _____ ft.

Sand _____

Gas _____

Oil _____

Total Depth _____

PRODUCTION

1st 24 hrs Nat. _____

1st 24 hrs. after shot _____

Gas _____ cu. ft.

Dry Hole _____

Abandoned _____

Map No. _____ Sec. 32 Twp. 26 R. 6


Lewis Oil Company

200 Ft. from N. Line

Ft. from S. Line

200 Ft. from E. Line

Ft. from W. Line

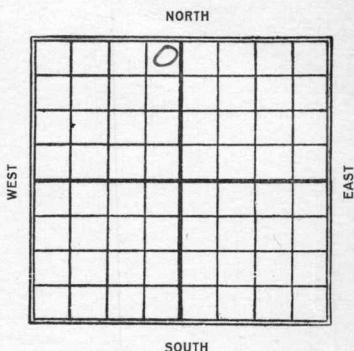

Date 1923

REPORT

1/6	Spud.
3/22	Sand 2768-78-50 Bblo. Nat.

Map No. KANSAS 14 Sec. 32 Twp. 26 R. 6
 Well No. 1. Jellison
Lewis Oil Company

Contractor _____

FIRST REPORT

SECTION PLAT

	6		

200 Ft. from N. Line
 _____ Ft. from S. Line
200 Ft. from E. Line
 _____ Ft. from W. Line

Location _____

Rig up _____

Drilling and Remarks:

spud

RECORD

Cased _____ in., _____ ft.

Sand _____

Gas _____

Oil _____

Total Depth _____

PRODUCTION

1st 24 hrs. Nat. _____

1st 24 hrs. after shot _____

Gas _____ Cu. Ft.

Dry Hole _____

Abandoned _____

Date

JAN 6 1923

M. A. BENEAR

191 _____

Scout

Map No. **KANSAS** 14 Sec. 32 Twp. 26 R. 6Well No. 1 JellisonLewis oil Company

Contractor

COMPLETED**SECTION PLAT**

200 Ft. from N. Line

Ft. from S. Line

200 Ft. from E. Line

Ft. from W. Line

Location

Rig up

Drilling and Remarks:

sand 52768'
12777'50 fbb
Nat.**RECORD**

Cased _____ in., _____ ft.

Sand _____

Gas _____

Oil _____

Total Depth _____

PRODUCTION

1st 24 hrs. Nat. _____

1st 24 hrs. after shot _____

Gas _____ Cu. Ft.

Dry Hole _____

Abandoned _____

Date

M. A. BENEAR**MAR 22 1923**

192

Scout