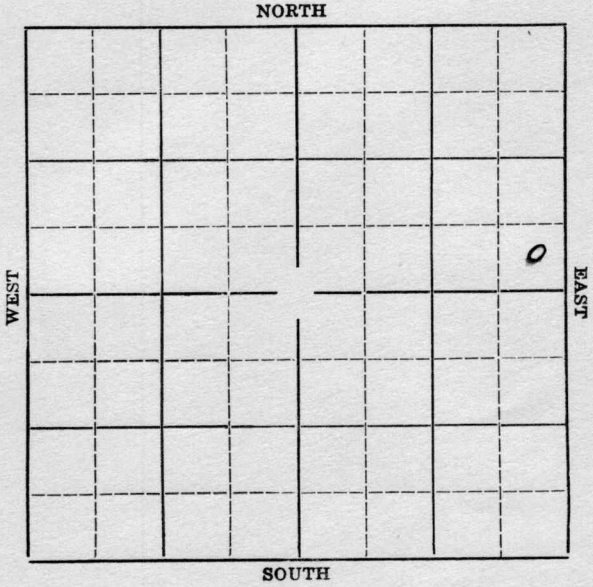
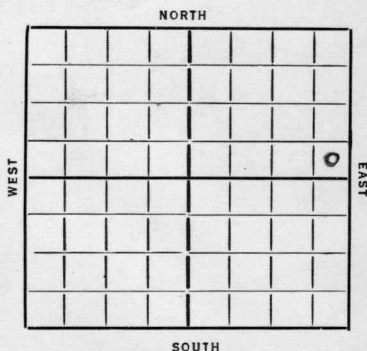


Section 17 Township 25- Range 2-EWell Number 1-ParkeCompany Dee Lauck

Map No. _____ Sec. 17 Twp. 25 R. 2EWell No. #1 Parke Farm __________Dee Lauck Company __________ Ft. from N. Line330' Ft. from S. Line330' Ft. from E. Line_____ Ft. from W. LineElev. 1411Date
1936

REPORT

4/29 Rigging up.5/7 Drlg. 685'.5/14 Drlg. 1600'.5/21 Drlg. 2100'.5/28 Drlg. 2800'.6/4 --6/11 Miss. Line. 2992'. Drlg. 3259'.6/24/36-Sil. 3507'.

HFW.

T.D. 3513'.

D&A

ABANDONED

KANSAS

Map No. 13 Sec. 17 Twp. 25 R. 2EWell No. 1 Park.Dec. Lawrence Company

Contractor

SECTION PLAT

			0

.....Ft. from N. Line

330 Ft. from S. Line330 Ft. from E. Line

.....Ft. from W. Line

FIRST REPORT

Location.....

Rig up.....

Drilling and Remarks:

Rigging up.

RECORD

Cased.....in.,ft.

Sand.....

Gas.....

Oil.....

Total Depth.....

PRODUCTION

1st 24 hrs. Nat.....

1st 24 hrs. after shot.....

Gas.....Cu. Ft.

Dry Hole.....

Abandoned.....

Date

APR 29 1936 192.....S. J. LEWIS

Scout

Map No. 13 Sec. 17 Twp. 25 R. 2EWell No. 1 ParkerDee Lauck Company

Contractor

SECTION PLAT

			0

_____ Ft. from N. Line

330 Ft. from S. Line330 Ft. from E. Line

_____ Ft. from W. Line

ABANDONED

Location _____

Rig up _____

Drilling and Remarks:

Oil 3507NFWJYA

RECORD

Cased _____ in., _____ ft.

Sand _____

Gas _____

Oil _____

Total Depth 3513

PRODUCTION

1st 24 hrs. Nat. _____

1st 24 hrs. after shot _____

Gas _____ Cu. Ft.

Dry Hole _____

Abandoned _____

Date

JUN 2 ± 1936₁₉

S. J. LEWIS Scout