


Map No. K15 Sec. 36 Twp. 25 R. 8Well No. 15 Bryden FarmMid-Kansas Company1320 Ft. from N. Line

Ft. from S. Line

1120 Ft. from E. Line

Ft. from W. Line

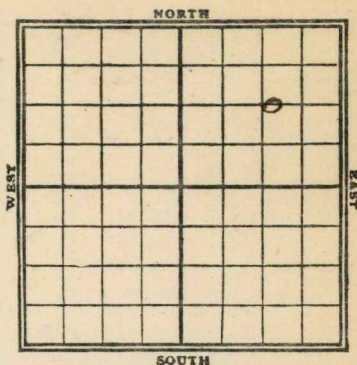

Date

REPORT

FIRST REPORT

COMPLETED

4/24	Rig up
5/1	✓
7	✓
6/3	1400'
17	2350 - 2406 start off
	4 string pipe
23	Log pipe sd. 2350-2406
7/2	✓
10	✓
22	✓
28	log pipe 2350
8/6	2406
8/13	skidding @ 2406
8/21	skidding rig
9/7	skid
9/13	✓
9/11	shy 6400'
9/15	✓ 960'
29	✓ 1300'
10-29	✓ 2,000
1921	
11/30	2350-2406 shot logs
	40 bbls.

Map No. K15 Sec. 36 Twp. 25 R. 8
 Well No. 15 Bryden
Mid - Kansas Company
 Contractor

SECTION PLAT

1320 Ft. from N. Line

_____ Ft. from S. Line

1120 Ft. from E. Line

_____ Ft. from W. Line



Location _____

Rig up ☒ _____

Drilling and Remarks:

RECORD

Cased _____ in., _____ ft.

Sand _____

Gas _____

Oil _____

Total Depth _____

PRODUCTION

1st 24 hrs. Nat. _____

1st 24 hrs. after shot _____

Gas _____ Cu. Ft.

Dry Hole _____

Abandoned _____

Date

4/24 1920

Pyle

Scout

Map No. K15 Sec. 36 Twp. 25 R. 8Well No. 15 BrydenMid-Kansas Company

Contractor

SECTION PLAT

1320 Ft. from N. Line

Ft. from S. Line

1120 Ft. from E. Line

Ft. from W. Line



Location

Rig up

Drilling and Remarks:

Shot 60 gts

RECORD

Cased _____ in., _____ ft.

Sand 2350 - 2406

Gas _____

Oil _____

Total Depth _____

PRODUCTION

1st 24 hrs. Nat. _____

1st 24 hrs. after shot 40 B

Gas _____ Cu. Ft.

Dry Hole _____

Abandoned _____

Date

Jan 30 1911**Pyle**

Scout