


Map No. Sec. 30 Twp. 26 R. 6

Well No. 1 Mc Clure Farm
Washabaugh & Foreman Company

NORTH

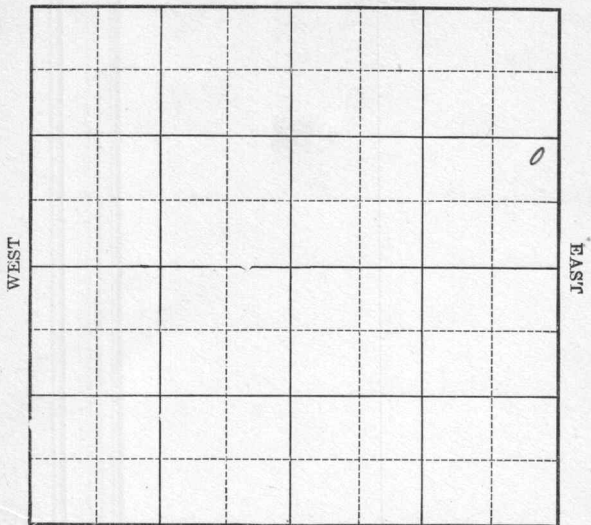

SOUTH

Location _____

Drilling Remarks _____

Rig Up _____

Drilling Remarks _____

RECORD

Cased _____ in. _____ ft.

Sand _____

Gas _____

Oil _____

Total Depth _____

PRODUCTION

1st 24 hrs. Nat. _____

1st 24 hrs. after shot _____

Gas _____ cu. ft.

Dry Hole _____

Abandoned _____

Butler

Map No. *Kanaw* Sec. *30* Twp. *26* R. *6*


Well No. *1 McClure* Farm
Washabaugh & Fortaker Company

_____ Ft. from N. Line

990 Ft. from S. Line

330 Ft. from E. Line

_____ Ft. from W. Line

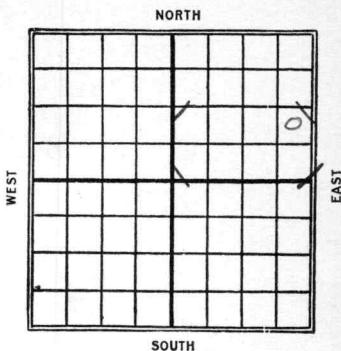

Date	REPORT
<i>1926</i>	
<i>6/9</i>	<i>Re-up</i>
<i>6/18</i>	—
<i>6/25</i>	—
<i>6-30</i>	—
<i>7/8</i>	—
<i>7/15</i>	—
<i>7/22</i>	—
<i>7/28</i>	—
<i>8/4</i>	—
<i>8/11</i>	—
<i>8/18</i>	—
<i>8/25</i>	—
<i>8/31</i>	—
<i>9/15</i>	—
<i>9/22</i>	<i>same</i>
<i>9/29</i>	—
<i>10/13</i>	—
<i>10/27</i>	<i>same</i>
<i>11/11</i>	<i>same</i>
<i>11/17</i>	—
<i>11/23</i>	—
<i>12/8</i>	—

12/15 / Same

12/22 _____

12/30 _____

~~1927~~

1/6 _____

1/13 _____

1/19 _____

1/26 _____ Rig up

2/3 - Drilling 475

2/10 - " 760

2/17 - " 1075

2/24 - Same

3/2 - 10" - 1705 - Drlg 1735

3/9 - S. D. 1735

3/16 _____

3/24 _____

3/30 _____

4/7 _____

4/13 _____

4/20 _____

4/27 _____

5/5 _____

5/12 - Drlg 2710

5/18 - Top line 2800 - Drlg 2831 -

5/25 - Shut down 2997 -

6/1 - S. D. 3055 for fuel -

6/7 Base line 3103

Sand 3178 - 83 show oil thru

AFW. lety 5"

6/15 - S. D. for 5" -

6/22 _____

6/29 _____

7/13 - Top line 2800' - 3103 (Base)

Sand 3178 - 3183 - show oil.

D. & A. 3190'

Butler

14 KANSAS

Map No. _____ Sec. 30 Twp. 26 R. 6

Well No. 1 Mc Clure

Woshbaugh & Foxaker Company

Contractor

COMPLETED

SECTION PLAT

_____ Ft. from N. Line

990 Ft. from S. Line

330 Ft. from E. Line

_____ Ft. from W. Line

ABANDONED

			o

Location _____

Rig up _____

Drilling and Remarks:

Top line - 2800
 base line - 3103
 Sand 3178-83
 show up
 ST 3190

RECORD

Cased _____ in., _____ ft.

Sand _____

Gas _____

Oil _____

Total Depth 2190 AFW

PRODUCTION

1st 24 hrs. Nat. _____

1st 24 hrs. after shot _____

Gas _____ Cu. Ft.

Dry Hole

Abandoned

Date

July 13 1927

CHAS. L. SHERWOOD

Scout

K14 KANSAS Sec. 30 Twp. 26 R. 6

Well No. 1 The Club Washbaugh & Zorabon Company

Contractor

FIRST REPORTS

SECTION PLAT

Ft. from N. Line

990

Ft. from S. Line

330

Ft. from E. Line

Ft. from W. Line

		X	X
		X	X

Location

Rig up ✓

Drilling and Remarks:

RECORD

Cased in., ft.

Sand

Gas

Oil

Total Depth

PRODUCTION

1st 24 hrs. Nat.

1st 24 hrs. after shot

Gas Cu. Ft.

Dry Hole

Abandoned

Date

JUN 9 1926

192

CHAS. L. SHERWOOD

Scout