


Section 18 Township 25 Range 1-E

Well No. 1 Shaffer

Company Max Steinbuchel et al

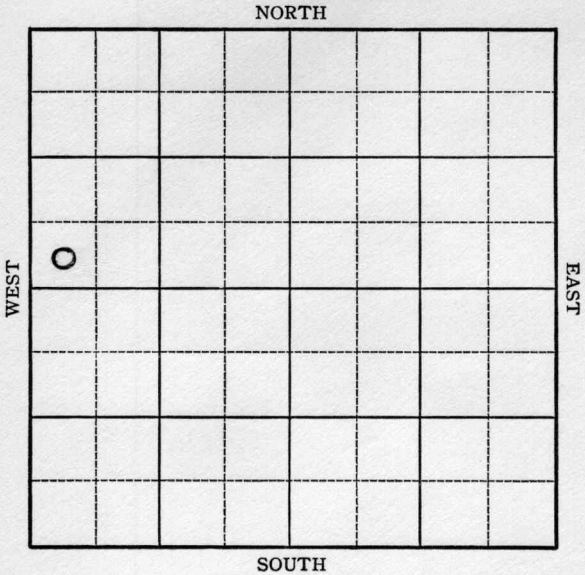

Sec. 18 Twp. 25 R. 1-E

Well No. #1 Shaffer Farm

Max Steinbuchel et al Company


 Ft. from N. Line

330 Ft. from S. Line

 Ft. from E. Line

330 Ft. from W. Line

Elev. 1396

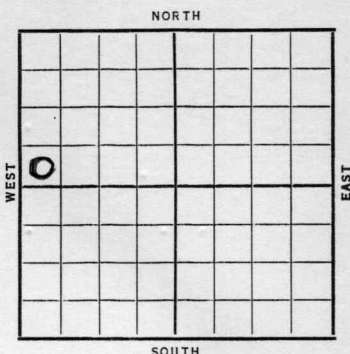

Date	REPORT
1937	
10/13	CR
10/22	15" @ 93'. Drlg. 545'.
10/29	12" @ 1242'. Drlg. 1490'.
11/5	10" @ 1950'. Drlg. 2112'.
11/12	8" @ 2129'. Topeka 2385'.
	H.F.W. 2500-10'. T.D. 2548'.
	U. R. 8".
11/19	8" @ 2520'. Drlg. 2640'.
11/26	Drlg. 3030'.
12/3	6" @ 3091'. Miss. 3109'.
	H.F.W. 3170-75'. Drlg. 3260'.
12/10	H.F.W. 3335-40'.
	T.D. 3368'. Reaming.
12/17	Base Miss. 3414'. 5" @ 3416'.
	H.F.W. 3485-87'. Drlg. 3581'.
12/24	Misner 3484'. Viola 3565'.
	Simp. 3600'. T.D. 3685'?
	No shows.
	OVER

1937

12/29 5" @ 3416'.

Simp. 3600'?

T.D. 3685'.

ABANDONED

