

Map No. _____ Sec. 36 Twp. 25 R. 8
Well No. 2 Ladd Farm
Sinclair Company

NORTH

WEST

EAST

SOUTH

Location -----

Drilling Remarks:

Rig Up -----

Drilling Remarks:

RECORD

Cased-----in. -----ft.

Sand -----

Gas _____

Oil_____

Total Depth -----

PRODUCTION

1st 24 hrs. Nat.-----

1st 24 hrs. after shot-----

Gas_____cu. ft

Dry Hole -----


Abandoned -----

Map No. K15 Sec. 36 Twp. 25 R. 8
 Well No. 2 Ladd
Sinclair O & Y Company
 Contractor

NORTH

WEST

EAST

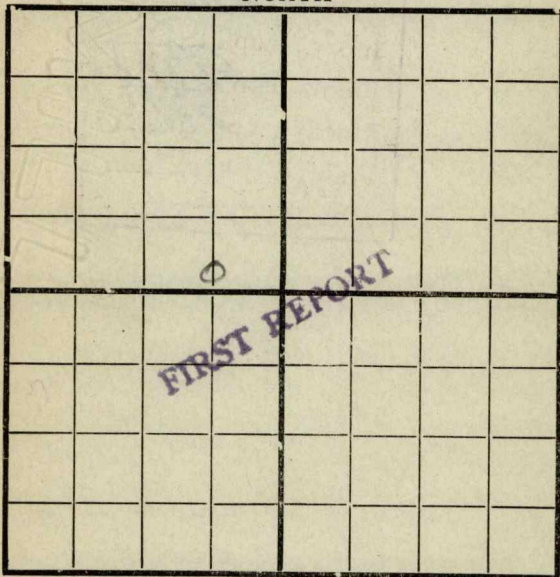

SOUTH

660 E

200 S

Location _____

Rig up _____

Drilling and Remarks:

RECORD

Cased _____ in., _____ ft.

Sand _____

Gas _____

Oil _____

Total Depth _____

PRODUCTION

1st 24 hrs. Nat. _____

1st 24 hrs. after shot _____

Gas _____ Cu. Ft.

Dry Hole _____

Abandoned _____

Date

6/6 1919

Scout

Map No. K 15 Sec. 36 Twp. 25 R. 8Well No. 2 LeadSimclair Oil Company

Contractor

NORTH

WEST

EAST

COMPLETED

SOUTH

660 E200 S

Location _____

Rig up _____

Drilling and Remarks:

RECORD

Cased _____ in., _____ ft.

Sand 2336-2380

Gas _____

Oil _____

Total Depth _____

PRODUCTION

1st 24 hrs. Nat. 100 bbls

1st 24 hrs. after shot _____

Gas _____ Cu. Ft.

Dry Hole _____

Abandoned _____

Date

6/201919Cycle

Scout