


Map No. _____ Sec. 26 Twp. 25 R. 8
Well No. 13 Bryden Farm _____
Giddell & St. Lawrence Company

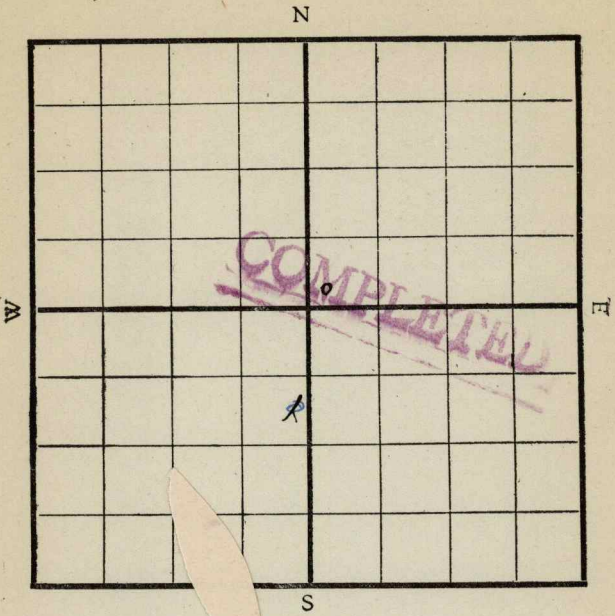

Location _____
Drilling Remarks: _____

RECORD

Cased _____ in. _____ ft.
Sand _____
Gas _____
Oil _____
Total Depth _____

Rig Up _____
Drilling Remarks: _____

PRODUCTION

1st 24 hrs. Nat. _____
1st 24 hrs. after shot _____
Gas _____ cu. ft.
Dry Hole _____
Abandoned _____

Map No. K 15 Sec. 36 Twp. 25 R. 8

Well No. 13 Bryden

Tidal & Southern Company

Contractor

SECTION PLAT

800 Ft. from N. Line

_____ Ft. from S. Line

200 Ft. from E. Line

_____ Ft. from W. Line

FIRST REPORT

Location _____

Rig up _____

Drilling and Remarks:

Spud

RECORD

Cased _____ in., _____ ft.

Sand _____

Gas _____

Oil _____

Total Depth _____

PRODUCTION

1st 24 hrs. Nat. _____

1st 24 hrs. after shot _____

Gas _____ Cu. Ft.

Dry Hole _____

Abandoned _____

Date

10/24 1919

Pyle

Scout

Map No. K 15 Sec. 36 Twp. 25 R. 8Well No. 13 BrydenTidal & Southern Company


Contractor

SECTION PLAT

Ft. from N. Line

200 Ft. from S. Line

Ft. from E. Line

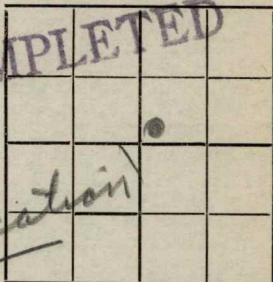200 Ft. from W. Line

Location

Rig up

Drilling and Remarks:

RECORD

Cased _____ in., _____ ft.

Sand 2339-2380

Gas _____

Oil _____

Total Depth _____

PRODUCTION

1st 24 hrs. Nat. 110 bbls

1st 24 hrs. after shot _____

Gas _____ Cu. Ft.

Dry Hole _____

Abandoned _____

Date

2/12 1920

Pyle

Scout