


Map No. _____ Sec. 36 Twp. 25 R. 8
Well No. 13 Bryden _____ Farm
Mid Kansas _____ Company

N

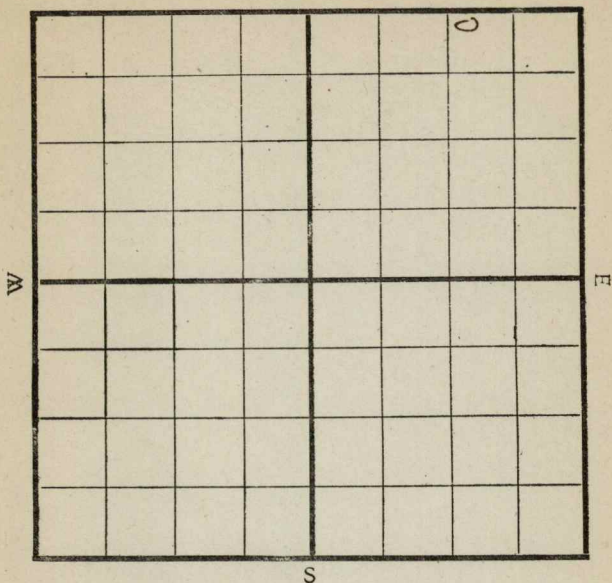

Location -----

Drilling Remarks:

Rig Up -----

Drilling Remarks:

Drilling Rema

COMPLETED

RECORD

Cased ----- in.-----ft.

Sand -----

Gas _____

Oil -----

Total Depth-----

PRODUCTION

1st 24 hrs. Nat.-----

1st 24 hrs. after shot-----

Gas ----- cu. ft

Dry Hole -----


Abandoned -----

Map No. _____ Sec. 36 Twp. 25 R. 8Well No. 1.3 Bryden Farm
Mid Kansas Company200 Ft. from N. Line

_____ Ft. from S. Line

1120 Ft. from E. Line

_____ Ft. from W. Line

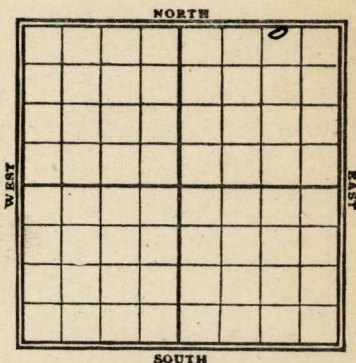1920
Date

REPORT

FIRST REPORT

2/8 Timbers

12 Trees

18 machine

27 Spud

3/13 Reg 950

19 ✓ 1250

4/10 ✓ 2245

15 Sand 2393-2435 Shot 40 gr
HFOil24 Sand 2393 HFOil
243520 Sand 2393-2435 TD 2442
40/150

COMPLETED

Map No. K15 Sec. 36 Twp. 25 R. 8Well No. 13 Bryden
Mid-Kansas Oil Company

Contractor _____

SECTION PLAT

200 Ft. from N. Line

_____ Ft. from S. Line

1120 Ft. from E. Line

_____ Ft. from W. Line

			<u>10</u>

Location _____

Rig up _____

Drilling and Remarks:

Timbers

RECORD

Cased _____ in., _____ ft.

Sand _____

Gas _____

Oil _____

Total Depth _____

PRODUCTION

1st 24 hrs. Nat. _____

1st 24 hrs. after shot _____

Gas _____ Cu. Ft.

Dry Hole _____

Abandoned _____

Date

7/81910Pyle

Scout

Map No. K15 Sec. 36 Twp. 25 R. 8Well No. 13 BrydenMid-Kansas Company

Contractor

SECTION PLAT

200 Ft. from N. Line

Ft. from S. Line

1120 Ft. from E. Line

Ft. from W. Line

			0

COMPLETED

Location

Rig up

Drilling and Remarks:

Shot 40 gts

RECORD

Cased _____ in., _____ ft.

Sand 2393-2435

Gas _____

Oil _____

Total Depth 2442

PRODUCTION

1st 24 hrs. Nat. _____

1st 24 hrs. after shot 150 bbl

Gas _____ Cu. Ft.

Dry Hole _____

Abandoned _____

Date

4/30 1910

Pyle

Scout