


Map No. _____ Sec. 36 Twp. 25 R. 8
 Well No. 14 Bryden Farm _____
West Kansas Company _____

N

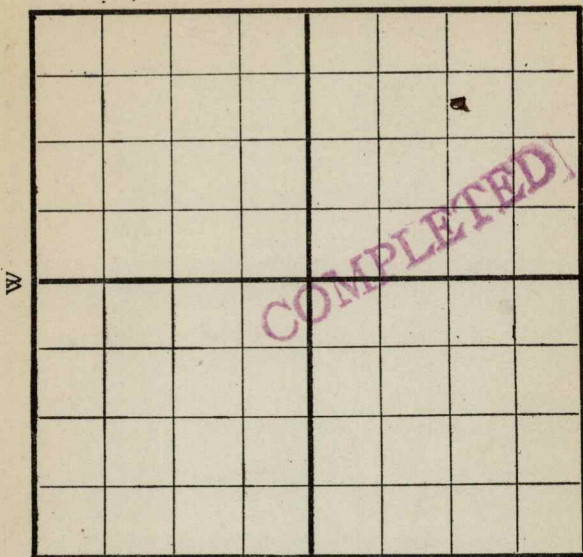

S

Location _____

Drilling Remarks:

Rig Up _____

Drilling Remarks:

RECORD

Cased _____ in. _____ ft.

Sand _____

Gas _____

Oil _____

Total Depth _____

PRODUCTION

1st 24 hrs. Nat. _____

1st 24 hrs. after shot _____

Gas _____ cu. ft.

Dry Hole _____

Abandoned _____

Map No. K14 Sec. 36 Twp. 25 R. 8
 Well No. 14 Bryden Farm _____
Mid-Kansas Oil Company


760 Ft. from N. Line

_____ Ft. from S. Line

1120 Ft. from E. Line

_____ Ft. from W. Line

COMPLETED

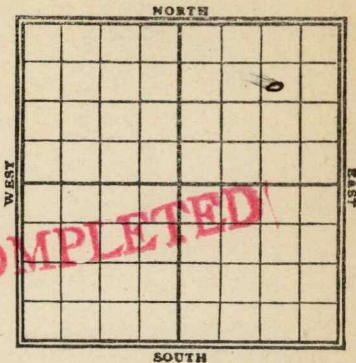

Kansas.

Date

REPORT

FIRST REPORT

3/30 Rig up

4/10

✓

15

✓

24

✓

5/1 Spud

7

670

6/3

1625

17

2352-99

40/15

Map No. K14 Sec. 36 Twp. 25 R. 8Well No. 14 BrydenMid-Kansas Oil Company

Contractor _____

SECTION PLAT

760 Ft. from N. Line

_____ Ft. from S. Line

1120 Ft. from E. Line

_____ Ft. from W. Line

Location _____

Rig up ☒ _____

Drilling and Remarks:

RECORD

Cased _____ in., _____ ft.

Sand _____

Gas _____

Oil _____

Total Depth _____

PRODUCTION

1st 24 hrs. Nat. _____

1st 24 hrs. after shot _____

Gas _____ Cu. Ft.

Dry Hole _____

Abandoned _____

Date

3/30 1920

Pyle Scout

Map No. K15 Sec. 36 Twp. 25 R. 8Well No. 14 BrydenMid-Kansas Oil Company

Contractor

SECTION PLAT

760 Ft. from N. Line

Ft. from S. Line

1120 Ft. from E. Line

Ft. from W. Line

			0

Location

Rig up

Drilling and Remarks:

Shot 40 gts

RECORD

Cased _____ in. _____ ft.

Sand 2352-99

Gas _____

Oil _____

Total Depth 2410

PRODUCTION

1st 24 hrs. Nat. _____

1st 24 hrs. after shot 15 bbls

Gas _____ Cu. Ft.

Dry Hole _____

Abandoned _____

Date

6/17 1920

Pyle

Scout