



Map No. \_\_\_\_\_ Sec. 36 Twp. 25 R. 8


Well No. 15 Bryden Farm  
Tidal & Yt So. Company

200 Ft. from N. Line

\_\_\_\_\_ Ft. from S. Line

\_\_\_\_\_ Ft. from E. Line

1120 Ft. from W. Line

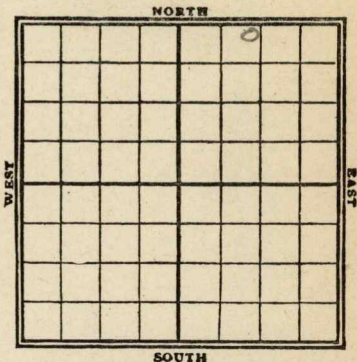

1926  
Date

REPORT

<u>2/8</u>	<u>Rig up</u>
<u>12</u>	<u>Tools</u>
<u>18</u>	<u>spud</u>
<u>27</u>	<u>Wlg 500'</u>
<u>3/13</u>	<u>Wery 1925</u>
<u>19</u>	<u>6" - 3360'</u>
<u>4/10</u>	<u>Sand 2438-44 - Shot 2096</u> <u>20660-</u>

FIRST REPORT

COMPLETED

Map No. K15 Sec. 36 Twp. 25 R. 8

Well No. 15 Bryden

Tidal & Southern Company

Contractor

SECTION PLAT

200 Ft. from N. Line

\_\_\_\_\_ Ft. from S. Line

\_\_\_\_\_ Ft. from E. Line

1120 Ft. from W. Line

		○	

FIRST REPORT

Location \_\_\_\_\_

Rig up  \_\_\_\_\_

Drilling and Remarks:

RECORD

Cased \_\_\_\_\_ in., \_\_\_\_\_ ft.

Sand \_\_\_\_\_

Gas \_\_\_\_\_

Oil \_\_\_\_\_

Total Depth \_\_\_\_\_

PRODUCTION

1st 24 hrs. Nat. \_\_\_\_\_

1st 24 hrs. after shot \_\_\_\_\_

Gas \_\_\_\_\_ Cu. Ft.

Dry Hole \_\_\_\_\_

Abandoned \_\_\_\_\_


Date

7/8 1920

Pyle

Scout

Map No. K15 Sec. 36 Twp. 25 R. 8  
 Well No. 15 Bryden Farm  
Tidal & Southern Company  
 Date Started \_\_\_\_\_ Ft. from N 200 S. E. W 120 line  
**NORTH**

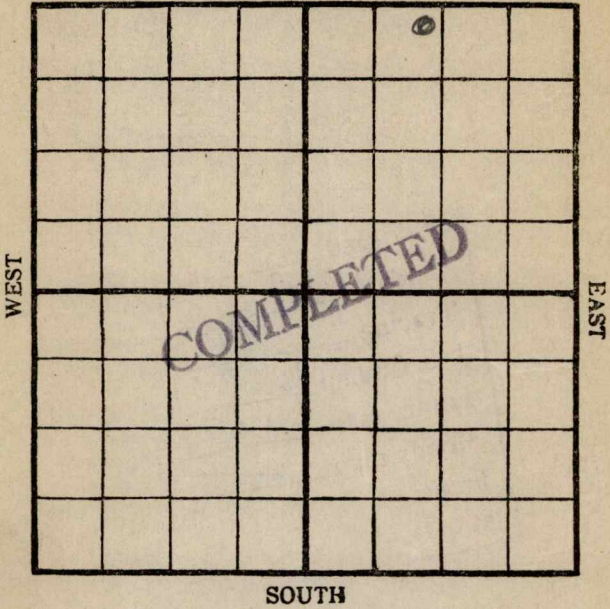

Cased _____ In. _____ Ft.	Production Remarks <u>Shot 20 qts</u> <u>1st 24 hrs 20 bbls</u>
Sand <u>2438-44</u>	
Pay { Gas _____ Oil _____	
Total Depth _____	

Condition of Well on this date \_\_\_\_\_

4/10

**Pyle**  
Scout