


Map No. _____ Sec. 36 Twp. 25 R. 8
Well No. 17 Bryden Farm _____
Lidal & St Southern Company

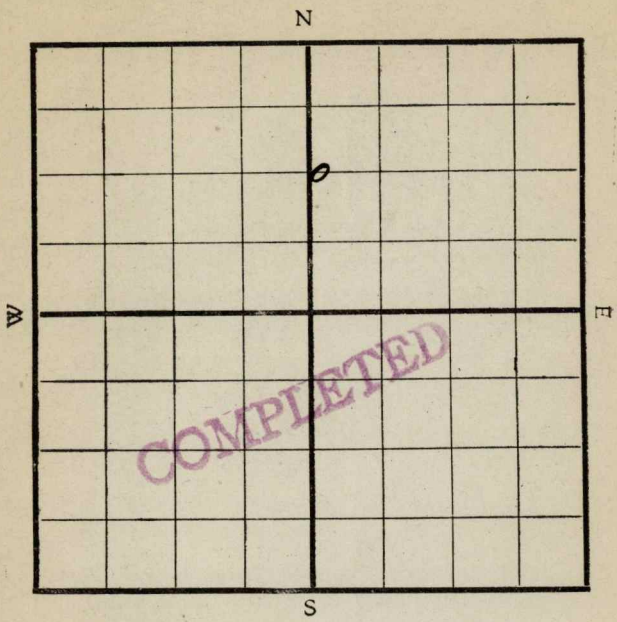

Location _____
Drilling Remarks:

Rig Up _____
Drilling Remarks:

RECORD

Cased _____ in. _____ ft.
Sand _____
Gas _____
Oil _____
Total Depth _____


PRODUCTION

1st 24 hrs. Nat. _____
1st 24 hrs. after shot _____
Gas _____ cu. ft.
Dry Hole _____
Abandoned _____

Map No. K Sec. 36 Twp. 25 R. 8Well No. 17 Bryden Farm
Lideal & Yt Son. Company1320 Ft. from N. Line

_____ Ft. from S. Line

_____ Ft. from E. Line

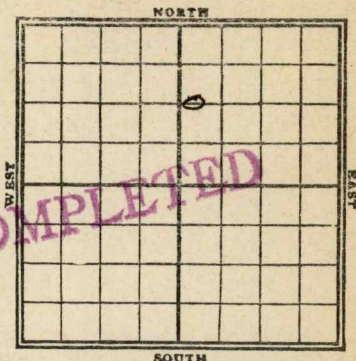200 Ft. from W. Line1960
DateREPORT **FIRST REPORT**3/13 By up.20 Loos4/10 Drig 46015 80024 ✓ 10005/1 ✓ 18507 ✓ 21302/20 2382-2410 25 Hls.

Map No. K 15 Sec. 36 Twp. 25 R. 8

Well No. 17 Bryden

Tidal & Southern Company

Contractor

SECTION PLAT

1320 Ft. from N. Line

----- Ft. from S. Line

----- Ft. from E. Line

200 Ft. from W. Line

		0	

FIRST REPORT

Location -----

Rig up ☒ -----

Drilling and Remarks:

RECORD

Cased ----- in., ----- ft.

Sand -----

Gas -----

Oil -----

Total Depth -----

PRODUCTION

1st 24 hrs. Nat. -----

1st 24 hrs. after shot -----

Gas ----- Cu. Ft.

Dry Hole -----

Abandoned -----

Date

Pyle

3/13 1920

Scout

Map No. 1515 Sec. 36 Twp. 25 R. 8Well No. 17 BrydenTidal & Southern Company

Contractor

SECTION PLAT

1320 Ft. from N. Line

Ft. from S. Line

Ft. from E. Line

200 Ft. from W. Line

		0	

COMPLETED

RECORD

Location

Cased _____ in., _____ ft.

Rig up

Sand 2382 - 2410

Drilling and Remarks:

Gas _____

Oil 2392 - 2404

Total Depth _____

PRODUCTION

1st 24 hrs. Nat. 25 bbls

1st 24 hrs. after shot _____

Gas _____ Cu. Ft.

Dry Hole _____

Abandoned _____

Date

5/20 191

Pyle

Scout