


Map No. K15 Sec. 36 Twp. 25 R. 8  
 Well No. 18 Bryden Farm  
Lidal & H. Lanthorn Company

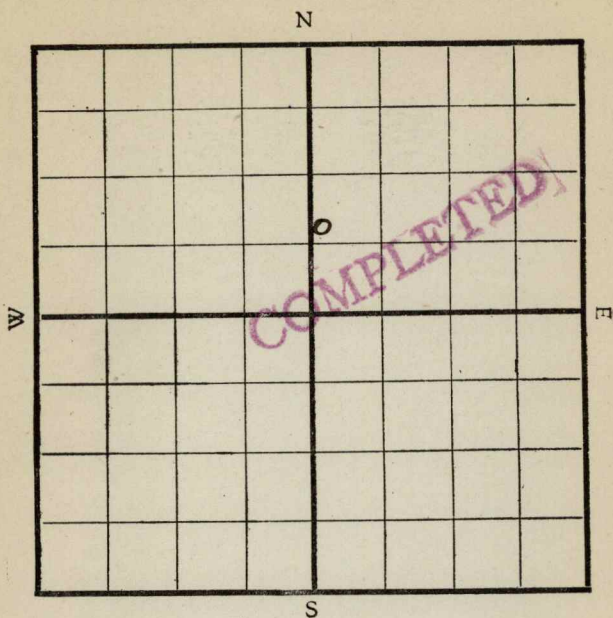

Location -----

Drilling Remarks:

Rig Up -----

Drilling Remarks:

RECORD

Cased ----- in. ----- ft.

Sand -----

Gas -----

Oil -----

Total Depth -----

PRODUCTION

1st 24 hrs. Nat. -----

1st 24 hrs. after shot -----

Gas ----- cu. ft.

Dry Hole -----


Abandoned -----

Map No. K15 Sec. 36 Twp. 25 R. 8Well No. 18 Bryden FarmIdal & H. Southern Company

\_\_\_\_\_ Ft. from N. Line

760 Ft. from S. Line

\_\_\_\_\_ Ft. from E. Line

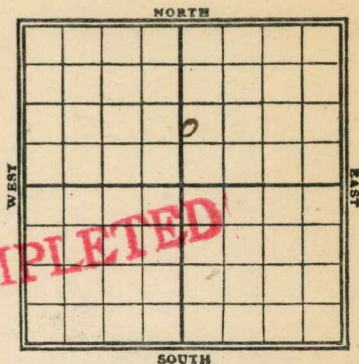Zero Ft. from W. Line

Date

REPORT **FIRST REPORT**4/24 Rig up5/1 Goose7 Spud6/3 Log. 2300'17 2345-69 30/50

Map No. K 15 Sec. 36 Twp. 25 R. 8Well No. 18 Bryden  
Lidul & St. Loathen Company

Contractor

## SECTION PLAT



Ft. from N. Line

760 Ft. from S. Line

Ft. from E. Line

200 Ft. from W. LineLocation ✓Rig up ✓

Drilling and Remarks:

## RECORD

Cased \_\_\_\_\_ in., \_\_\_\_\_ ft.

Sand \_\_\_\_\_

Gas \_\_\_\_\_

Oil \_\_\_\_\_

Total Depth \_\_\_\_\_

## PRODUCTION

1st 24 hrs. Nat. \_\_\_\_\_

1st 24 hrs. after shot \_\_\_\_\_

Gas \_\_\_\_\_ Cu. Ft.

Dry Hole \_\_\_\_\_

Abandoned \_\_\_\_\_

Date

4/24 1910

Pyle

Scout

Map No. K15 Sec. 36 Twp. 25 R. 8Well No. 18 BrydenTidal & Southern Company

Contractor

## SECTION PLAT

Ft. from N. Line

760 Ft. from S. Line

Ft. from E. Line

200 Ft. from W. Line

|  |  |  |  |
|--|--|--|--|
|  |  |  |  |
|  |  |  |  |
|  |  |  |  |
|  |  |  |  |

COMPLETED

Location

Rig up

Drilling and Remarks:

Shot 309 ft

## RECORD

Cased \_\_\_\_\_ in., \_\_\_\_\_ ft.

Sand 2345-69

Gas \_\_\_\_\_

Oil \_\_\_\_\_

Total Depth \_\_\_\_\_

## PRODUCTION

1st 24 hrs. Nat. \_\_\_\_\_

1st 24 hrs. after shot 50 bbls

Gas \_\_\_\_\_ Cu. Ft.

Dry Hole \_\_\_\_\_

Abandoned \_\_\_\_\_

Date

6/17 19120

Pyle

Scout