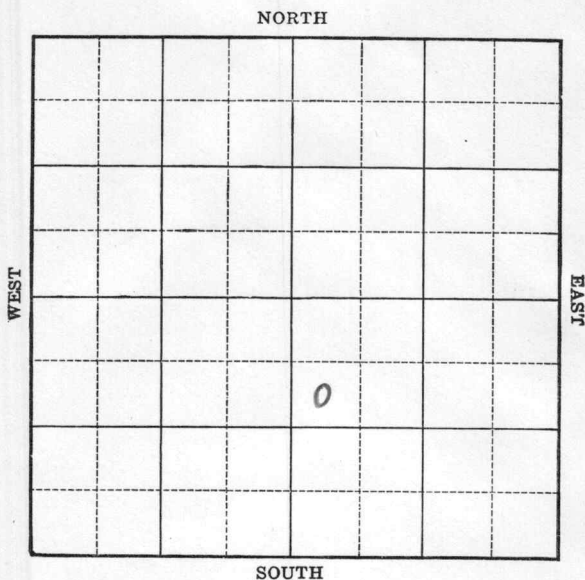


Section 29 Township 26 Range 6EWell No. #2 YinglingCompany M & B Oil

Company

Ft. from N. Line


Ft. from S. Line

Ft. from E. Line

330

Ft. from W. Line

Elev. 1386

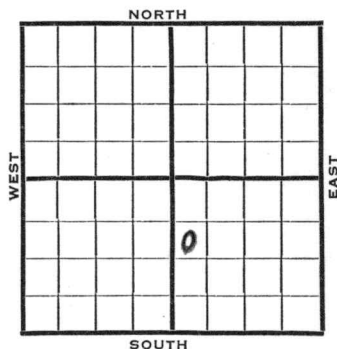[illegible]

Map No. 14 Sec. 29 Twp. 26 R. 6EWell No. 2 YinglingM & B Oil Company

Contractor _____

FIRST REPORT

SW NW SE

990 Ft. from N. Line

_____ Ft. from S. Line

_____ Ft. from E. Line

330 Ft. from W. Line

SECTION PLAT

		o	

MISCELLANEOUS

Location _____

Rig up _____

Drilling and Remarks:

Mach.

RECORD

Cased _____ in., _____ ft.

Sand _____

Gas _____

Oil _____

Total Depth _____

PRODUCTION

1st 24 hrs. Nat. _____

1st 24 hrs. after shot _____

Gas _____ Cu. Ft.

Dry Hole _____

Abandoned _____

Date

JUL 10 1940 19S. J. LEWIS Scout

KANSAS

Map No. 14 Sec. 29 Twp. 26 R. 6EWell No. 2 Yingling

M & B Oil

Company

Contractor

COMPLETED
SW NW SE

SECTION PLAT

990 Ft. from N. Line

Ft. from S. Line

Ft. from E. Line

330 Ft. from W. Line

MISCELLANEOUS

Location

Rig up

Drilling and Remarks:

*Well 2758.**6" @ 2758.**2000 acid**Pump 25 Bx.*

RECORD

Cased _____ in., _____ ft.

Sand _____

Gas _____

Oil _____

Total Depth 2787

PRODUCTION

1st 24 hrs. Nat. _____

1st 24 hrs. after shot _____

Gas _____ Cu. Ft.

Dry Hole _____

Abandoned _____

Date

AUG 28 1940

19

S. J. LEWIS Scout