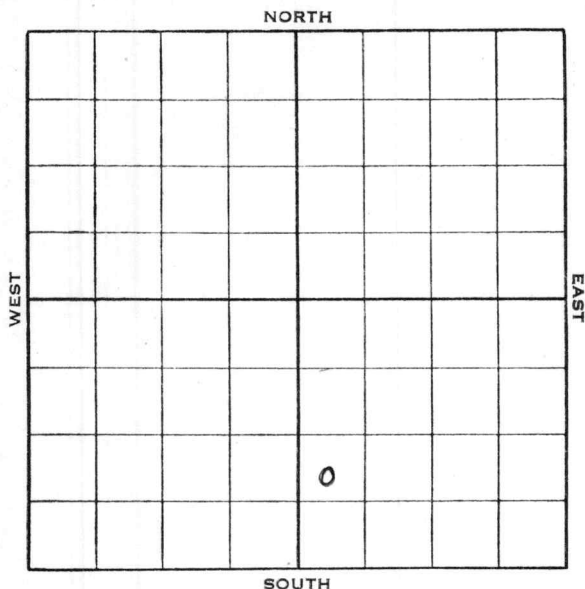


Butler

KANSAS


Section 29 Township 26 Range 6-EWell No. #1 YinglingCompany Isadore Molk

KANSAS

Butler

Sec. 29 Twp. 26 R. 6-EWell No. #1 Yingling Farm
Isadore Molk Company Ft. from N. Line860 Ft. from S. Line Ft. from E. Line330 Ft. from W. Line

Elev. 1388'.

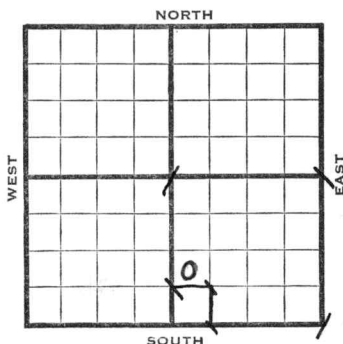

1938	REPORT
9/28	Location
10/7	Cellar.
10/14	Spud.
10/21	12" - 750'.
	Dlg. 760'.
10/28	10" - 1398'. Dlg. 1840'.
11/4	10" - 2227'. Dlg. 2380'.
11/12	T. D. 2779'. 5" - 2765'. U. R.
11/18	Miss. 2769'. 5" - 2769'.
	S. O. 2773-79'. WOC.
11/22	5" - 2769'..
	Miss. 2769'.
	T. D. 2784'.
	2000 acid.
	50 oil and 2% water.
	COMPLETED

Butler KANSAS

Map No. 14 Sec. 29 Twp. 26 R. 6EWell No. 1 YinglingIsadore Molk

Company

Contractor

FIRST REPORT

Approx.

NW SW SE


Ft. from N. Line

860 Ft. from S. Line

Ft. from E. Line

330 Ft. from W. Line

SECTION PLAT

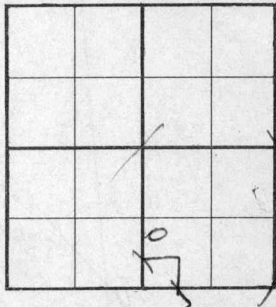Location X

Rig up

Drilling and Remarks:

RECORD

Cased _____ in., _____ ft.

Sand _____

Gas _____

Oil _____

Total Depth _____

PRODUCTION

1st 24 hrs. Nat. _____

1st 24 hrs. after shot _____

Gas _____ Cu. Ft.

Dry Hole _____

Abandoned _____

Date

SEP 28 1938

19

H. D. Hatfield

Scout

Butler

KANSAS

Map No. 14 Sec. 29 Twp. 26 R. 6EWell No. 1 YinglingIsadore Molk Company

Contractor

COMPLETED

Approx.

NW SW SE

 Ft. from N. Line860 Ft. from S. Line Ft. from E. Line330 Ft. from W. Line

SECTION PLAT

		0	

Location Rig up Drilling and Remarks: 2000 acid50 oil290 wtr

RECORD

Cased 5 in., 2769 ft.~~Sand~~ MISS 2769Gas Oil Total Depth 2784

PRODUCTION

1st 24 hrs. Nat. 1st 24 hrs. after shot Gas Cu. Ft.Dry Hole Abandoned

Date

NOV 22 1938

19

H. D. Hatfield

Scout