


Map No. _____ Sec. 36 Twp. 25 R. 8
 Well No. 1 Ladd Farm _____
Sinclair Oil & G Company

NORTH

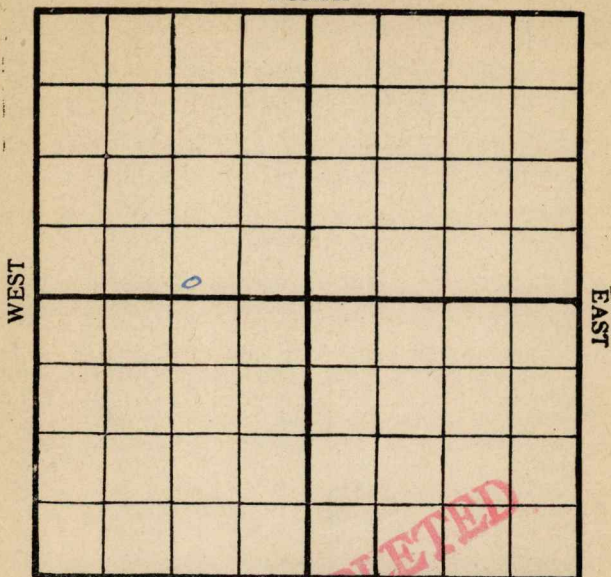

SOUTH

Location _____

Rig Up _____

Drilling Remarks:

Drilling Remarks:

RECORD

PRODUCTION

Cased _____ in. _____ ft.
 Sand _____
 Gas _____
 Oil _____
 Total Depth _____

1st 24 hrs. Nat. _____
 1st 24 hrs. after shot _____
 Gas _____ cu. ft.
 Dry Hole _____
 Abandoned _____

Map No. K15 Sec. 36 Twp. 25 R. 8Well No. 1 LaddSinclair Oil Co. Company

Contractor

NORTH

WEST

EAST

SOUTH

FIRST REPORT

Location _____

Rig up ☒

Drilling and Remarks:

1120'
~~1520'~~ E
 200' X S

RECORD

Cased _____ in., _____ ft.

Sand _____

Gas _____

Oil _____

Total Depth _____

PRODUCTION

1st 24 hrs. Nat. _____

1st 24 hrs. after shot _____

Gas _____ Cu. Ft.


Dry Hole _____

Abandoned _____

Date

8/19 1918Pyle Scout

Map No. K15 Sec. 36 Twp. 25^s R. 8^E
 Well No. 1 Ladd
Sinclair Oil Company
 Contractor _____

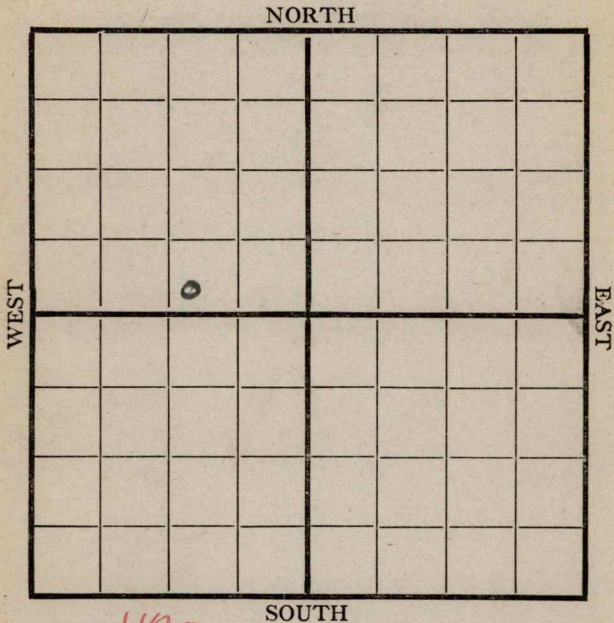

1120
~~1520E~~
200N

Location _____
 Rig up _____
 Drilling and Remarks:

Rigging up

RECORD

Cased _____ in., _____ ft.
 Sand _____
 Gas _____
 Oil _____
 Total Depth _____

PRODUCTION

1st 24 hrs. Nat. _____
 1st 24 hrs. after shot _____
 Gas _____ Cu. Ft.
 Dry Hole _____
 Abandoned _____


Date

8/30 1918

Pyle

Scout

Map No. 1515 Sec. 36 Twp. 25 S 8 E R. 8
 Well No. 1 Ladd
Sinclair O & G. Company
 Contractor

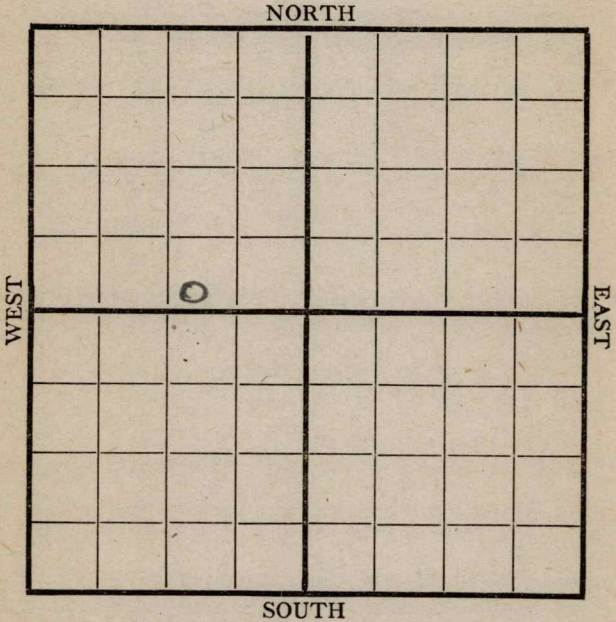

	RECORD
Location _____	Cased _____ in., _____ ft.
Rig up _____	Sand _____
Drilling and Remarks:	Gas _____
<u>1520 from 26.</u>	Oil _____
<u>200 " S.</u>	Total Depth _____
<u>250'</u>	
	PRODUCTION
	1st 24 hrs. Nat. _____
	1st 24 hrs. after shot _____
	Gas _____ Cu. Ft.
	Dry Hole _____
	Abandoned _____

Date 9/6 1918 Pyle Scout

Map No. 115 Sec. 36 Twp. 25 R. 8

Well No. 1 Ladd
Snclair O & G Company

Contractor

		NORTH			
WEST					
		SOUTH			
		EAST			

Location 1120 E

Rig up 2009

Drilling and Remarks:

850

RECORD

Cased _____ in., _____ ft.

Sand _____

Gas _____

Oil _____

Total Depth _____

PRODUCTION

1st 24 hrs. Nat. _____

1st 24 hrs. after shot _____

Gas _____ Cu. Ft.

Dry Hole _____

Abandoned _____

Date

9/10

191

8

Pyle Scout

Map No. K15 Sec. 36 Twp. 25 R. 8Well No. 1 LaddSinclair O & G. Company

Contractor

NORTH

WEST

EAST

SOUTH

Location 1120 ERig up 200-S

Drilling and Remarks:

1115'

RECORD

Cased _____ in., _____ ft.

Sand _____

Gas _____

Oil _____

Total Depth _____

PRODUCTION

1st 24 hrs. Nat. _____

1st 24 hrs. after shot _____

Gas _____ Cu. Ft.

Dry Hole _____

Abandoned _____

Date

9/20

191

8Ryle

Scout

Map No. K15 Sec. 36 Twp. 25 R. 8Well No. 1 Ladd
Sinclair O & G. Company

Contractor

NORTH

WEST

EAST

SOUTH

Location 1120 ERig up 200-5

Drilling and Remarks:

1165'

RECORD

Cased _____ in., _____ ft.

Sand _____

Gas _____

Oil _____

Total Depth _____

PRODUCTION

1st 24 hrs. Nat. _____

1st 24 hrs. after shot _____

Gas _____ Cu. Ft.

Dry Hole _____

Abandoned _____

Date


9/231918Pyle

Scout

Map No. K15 Sec. 36 Twp. 25 R. 8Well No. 1 Ladd FarmSinclair O & G Company

NORTH

WEST

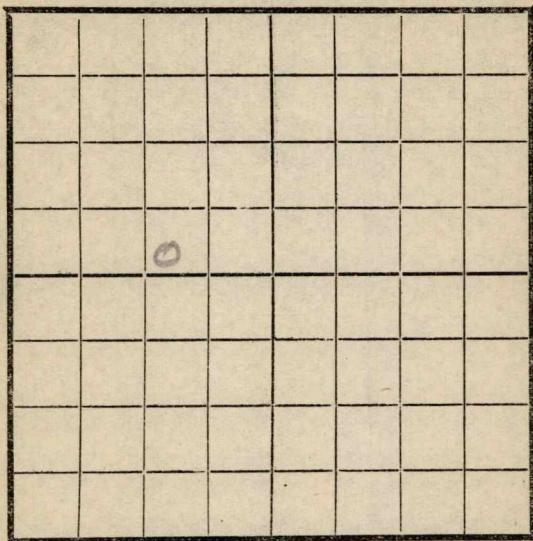

SOUTH

Location 1120 ERig Up 200 S

Drilling and remarks

1460

RECORD

Cased _____ in. _____ Ft.

Sand _____

Gas _____

Oil _____

Total Depth _____

PRODUCTION

1st 24 hrs. Nat. _____

1st 24 hrs. after shot _____

Gas _____ Cu. Ft.

Dry Hole _____

Abandoned _____

Date

9/30, 1918Pyle


Scout

Map No. K15 Sec. 36 Twp. 25 R. 8

Well No. 1 Ladd Farm
Sinclair O & G. Company

NORTH

WEST

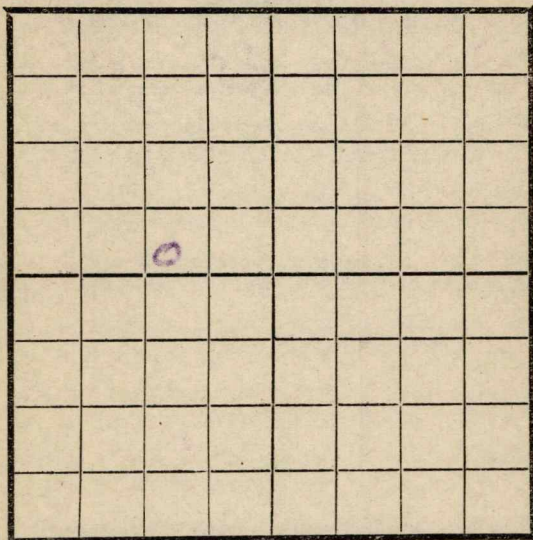

EAST

SOUTH

Location 1120-E

Rig Up 200 S

Drilling and remarks

D. 10 @

2340'

RECORD

Cased _____ in. _____ Ft.

Sand _____

Gas _____

Oil _____

Total Depth _____

PRODUCTION

1st 24 hrs. Nat. _____

1st 24 hrs. after shot _____

Gas _____ Cu. Ft.

Dry Hole _____

Abandoned _____

Date

10/7, 1918 Dyer Scout

Map No. K15 Sec. 36 Twp. 25 R. 8Well No. 1 LaddSimclair O & S. Company

Contractor

NORTH

WEST

EAST

SOUTH

Location 1120-ERig up 200-S

Drilling and Remarks:

1600 ft oil
in hole
will shoot

RECORD

Cased _____ in., _____ ft.

Sand 2306-2340

Gas _____

Oil _____

Total Depth _____

PRODUCTION

1st 24 hrs. Nat. _____

1st 24 hrs. after shot _____

Gas _____ Cu. Ft.

Dry Hole _____

Abandoned _____

Date

12/14 1918

Pyle


Scout

Map No. K15 Sec. 36 Twp. 25 R. 8Well No. 1 Ladd
Sinclair O & G. Company

Contractor

NORTH

WEST

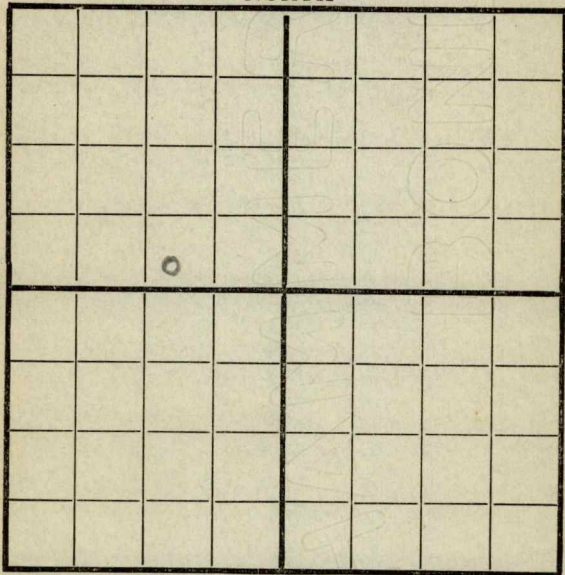

EAST

SOUTH

Location 1120-ERig up 200-S

Drilling and Remarks:

rig up.

RECORD

Cased _____ in., _____ ft.

Sand _____

Gas _____

Oil _____

Total Depth _____

PRODUCTION

1st 24 hrs. Nat. _____

1st 24 hrs. after shot _____

Gas _____ Cu. Ft.

Dry Hole _____

Abandoned _____

Date

10-25 191 8 Pyle Scout

Map No. K15 Sec. 36 Twp. 25 R. 8

Well No. 1 Ladd

Sinclair Oil Co. Company

Contractor

NORTH

WEST

EAST

SOUTH

Location 200-S

Rig up 1120-E

Drilling and Remarks:

fishing
casing @
2086

RECORD

Cased-----in., -----ft.

Sand 2306-2346

Gas _____

Oil_____

Total Depth_____

PRODUCTION

1st 24 hrs. Nat. -----

1st 24 hrs. after shot-----

Gas.....Cu. Ft.

Dry Hole.....

Abandoned_____

Date _____

191

Pyle

Scout

Map No. 115 Sec. 36 Twp. 25 R. 8Well No. 1 LaddSinclair @ Y.L. Company

Contractor

NORTH

WEST

EAST

SOUTH

COMPLETED

Location 1120-ERig up 200-S

Drilling and Remarks:

Exp 20 bbls
making a
lot of water

RECORD

Cased _____ in., _____ ft.

Sand 2306-2346

Gas _____

Oil _____

Total Depth _____

PRODUCTION

1st 24 hrs. Nat. _____

1st 24 hrs. after shot _____

Gas _____ Cu. Ft.

Dry Hole _____

Abandoned _____

Date

191

Pyle

Scout