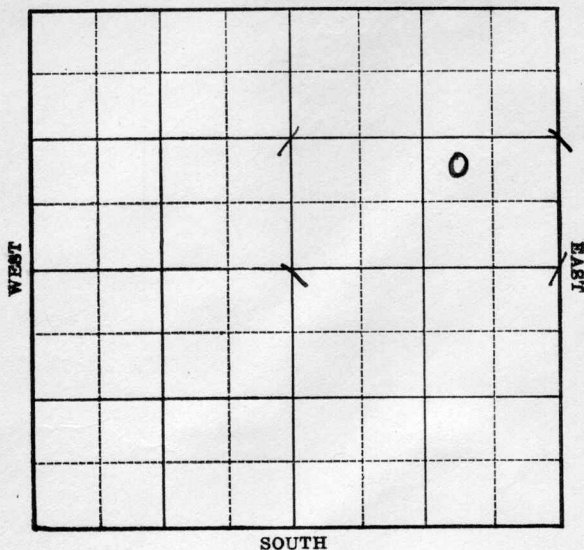


Section 21 Township 25 Range 1-EWell No. 1 BlackCompany Ace OilNORTH Goodrick Pool

Sec. 21 Twp. 25 R. 1-E

Well No. #1 Black Farm

Ace Oil

Company

(Goodrich)


_____ Ft. from N. Line

990 Ft. from S. Line

990 Ft. from E. Line

Ft. from W. Line

Elev. 1435

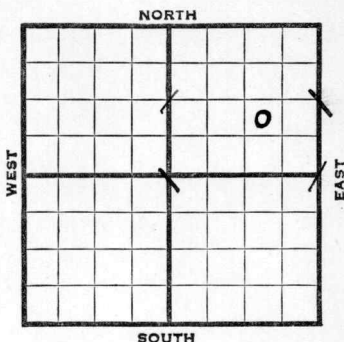

1939	REPORT
3/1	RU & SD.
3/10	Spud.
3/17	20" - 25' 15" - 182' Drlg. 745'
3/24	12" - 1300' Drlg. 1595'
3/31	Drlg. 2045'
4/7	8" - 2165' Lans. ²²⁷⁹ 2280 ' T.D. ²²⁸⁰ H.F.O. - 20 min. SD Tanks.
4/12	8" - 2165' 6" liner on bottom. Lans. 2279' T. D. 2280' Pump 658 bbls. 8 hrs. Potential 1975 bbls.
	COMPLETED

Map No. 13 Sec. 21 Twp. 25 R. 1EWell No. 1 BlackAce Oil Company

Contractor


FIRST REPORT

NW SE NE

 Ft. from N. Line990 Ft. from S. Line990 Ft. from E. Line Ft. from W. Line

GOODRICH POOL

SECTION PLAT

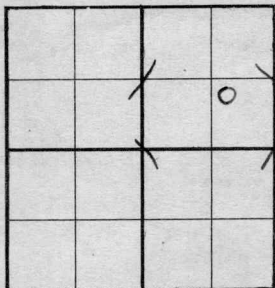Location Rig up

Drilling and Remarks:

RIGGED UP & S.D.

RECORD

Cased in., ft.Sand Gas Oil Total Depth

PRODUCTION

1st 24 hrs. Nat. 1st 24 hrs. after shot Gas Cu. Ft.Dry Hole Abandoned

Date

MAR 1 - 1939 19 H. D. Hatfield Scout

Sedgwick **KANSAS**Map No. 13 Sec. 21 Twp. 25 R. 1EWell No. 1 BlackAce Oil Company

Contractor

COMPLETED

NW SE NE

 Ft. from N. Line990 Ft. from S. Line990 Ft. from E. Line Ft. from W. Line**GOODRICH Pool****SECTION PLAT**

			0

Location Rig up

Drilling and Remarks:

RECORDCased 8" in 2165Sand 6" liner on bottom LENS 2279Gas Oil Total Depth 2280**PRODUCTION**1st 24 hrs. Nat. 1st 24 hrs. after shot Gas Cu. Ft.Dry Hole Abandoned

Date

APR 12 1939

19

H. D. Hatfield

Scout

*P-658/8**Pot 1975*