


Map No. _____ Sec. 36 Twp. 25 R. 8
 Well No. 3 Ladd Farm _____
McClair Company _____

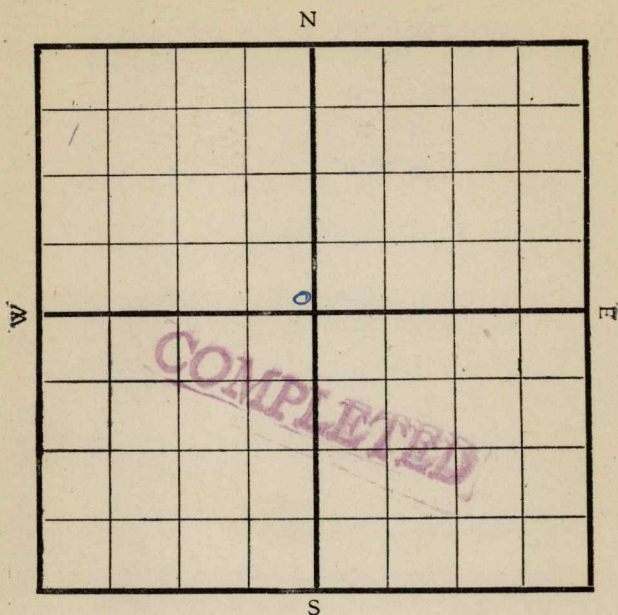

Location _____

Drilling Remarks:

Rig Up _____

Drilling Remarks:

RECORD

Cased _____ in. _____ ft.

Sand _____

Gas _____

Oil _____

Total Depth _____

PRODUCTION

1st 24 hrs. Nat. _____

1st 24 hrs. after shot _____

Gas _____ cu. ft.

Dry Hole _____

Abandoned _____

Map No. _____ Sec. 36 Twp. 25 R. 8

Well No. 3. Ladd Farm _____

Dinclair Oil & Gas Co. Company _____

Contractor _____


NW Quarter

_____ Ft. from N. Line

200 Ft. from S. Line

200 Ft. from E. Line

_____ Ft. from W. Line

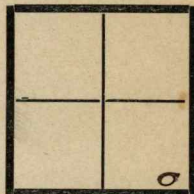

REPORT

FIRST REPORT

10/14

Rig up

10/24

Spudding

11/7

Drill 1300'

12/6

Drill 2260'

1/3/20

S.W. 2000'

8

Land 2338' - 2399' - Shot
30 gts - 70 bbl.

COMPLETED

Map No. K 15 Sec. 36 Twp. 25 R. 8Well No. 3 LaddSinclair Oil Co. Company

Contractor

SECTION PLAT

----- Ft. from N. Line

200 Ft. from S. Line200 Ft. from E. Line

----- Ft. from W. Line

Location -----

Rig up ☒ -----

Drilling and Remarks:

RECORD

Cased ----- in., ----- ft.

Sand -----

Gas -----

Oil -----

Total Depth -----

PRODUCTION

1st 24 hrs. Nat. -----

1st 24 hrs. after shot -----

Gas ----- Cu. Ft.

Dry Hole -----

Abandoned -----

Date

10/24 1919

Pyle

Scout

Map No. H 15 Sec. 36 Twp. 25 R. 8Well No. 3 LaddSinclair O & G Company

Contractor

SECTION PLAT

----- Ft. from N. Line

200 Ft. from S. Line200 Ft. from E. Line

----- Ft. from W. Line



Location -----

Rig up -----

Drilling and Remarks:

Shot 30 gts

RECORD

Cased ----- in., ----- ft.

Sand 2338-2399

Gas -----

Oil -----

Total Depth -----

PRODUCTION

1st 24 hrs. Nat. -----

1st 24 hrs. after shot 70 bbls

Gas ----- Cu. Ft.

Dry Hole -----

Abandoned -----

Date

1/8 1919Pyle Scout