



Butler

Map No. KANSAS Sec. 29 Twp 26 R. 6 E


Well No. 2 Wagoner Farm  
Texas Co. Company

\_\_\_\_\_ Ft. from N. Line

330 Ft. from S. Line

990 Ft. from E. Line

\_\_\_\_\_ Ft. from W. Line

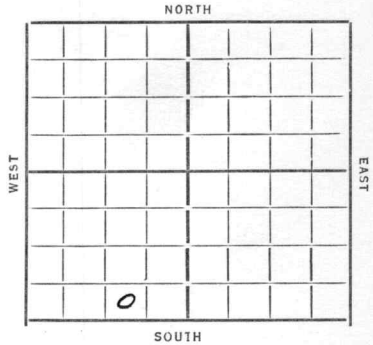

Date 1954

REPORT

<u>7/3</u>	<u>Location</u>
<u>7/12</u>	<u>— 7/19 —</u>
<u>7/26</u>	<u>TD 430</u>
<u>8/2</u>	<u>dly 870</u>
<u>8/9</u>	<u>" 1700</u>
<u>8/16</u>	<u>" 2200</u>
<u>8/23</u>	<u>" 2400</u>
<u>8/30</u>	<u>TL 2761 Run 5"</u>
<u>9/6</u>	<u>2790 TD 1700' oil seepage</u>
<u>9/13</u>	<u>Pump 10 Bbls per day.</u>
<u>9/20</u>	<u>—</u>
<u>9/26</u>	<u>line 2761 TD 2790</u>
	<u>500 acid Dr A.</u>

ABANDONED

KANSAS

Map No. 14 Sec. 29 Twp. 26 R. 6E

Well No. 2-Wagoner

Texas Co Company

Contractor

FIRST REPORTS

SECTION PLAT


\_\_\_\_\_ Ft. from N. Line

330 Ft. from S. Line

990 Ft. from E. Line

\_\_\_\_\_ Ft. from W. Line

Location

Rig up \_\_\_\_\_

Drilling and Remarks:

RECORD

Cased \_\_\_\_\_ in., \_\_\_\_\_ ft.

Sand \_\_\_\_\_

Gas \_\_\_\_\_

Oil \_\_\_\_\_

Total Depth \_\_\_\_\_

PRODUCTION

1st 24 hrs. Nat. \_\_\_\_\_

1st 24 hrs. after shot \_\_\_\_\_

Gas \_\_\_\_\_ Cu. Ft.

Dry Hole \_\_\_\_\_

Abandoned \_\_\_\_\_

Date

7-3-34 19

ORVAL MANNSCHRECK

Scout

KANSAS

Map No. 14 Sec. 29 Twp. 26 R. 6E

Well No. 2-Wagoner

Texas CV Company

Contractor

ABANDONED

SECTION PLAT


\_\_\_\_\_ Ft. from N. Line

330 Ft. from S. Line

990 Ft. from E. Line

\_\_\_\_\_ Ft. from W. Line

Location \_\_\_\_\_

Rig up \_\_\_\_\_

Drilling and Remarks:

500 acid

10 x 7 1/2

RECORD

Cased \_\_\_\_\_ in., \_\_\_\_\_ ft.

Sand Lime 2761

Gas \_\_\_\_\_

Oil \_\_\_\_\_

Total Depth 2790

PRODUCTION

1st 24 hrs. Nat. \_\_\_\_\_

1st 24 hrs. after shot \_\_\_\_\_

Gas \_\_\_\_\_ Cu. Ft.

Dry Hole \_\_\_\_\_

Abandoned \_\_\_\_\_

Date

9-26-37 19

ORVAL MANNSCHRECK

Scout