


Butler

KANSAS

Section 29 Township 26 Range 6-E

Well No. #1 Wagner

Company Isadore Molk

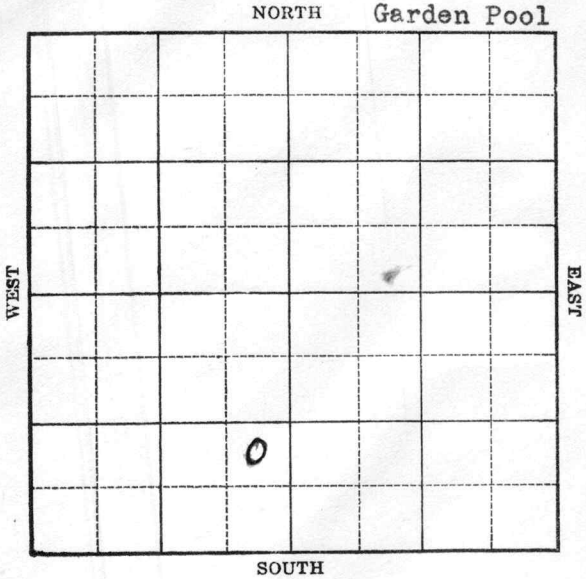

Butler

KANSAS

Map No. 14 Sec. 29 Twp. 26 R. 6EWell No. 1 WagnerIsadore Molk

Company

Contractor

FIRST REPORT

NE SE SW

 Ft. from N. Line990 Ft. from S. Line330 Ft. from E. Line Ft. from W. Line

SECTION PLAT

GARDEN POOL

Location Rig up

Drilling and Remarks:

10" - 1371Dr1g. 1700

RECORD

Cased in., ft.Sand Gas Oil Total Depth

PRODUCTION

1st 24 hrs. Nat. 1st 24 hrs. after shot Gas Cu. Ft.Dry Hole Abandoned

Date

JAN 11 - 1939 19H. D. Hatfield

Scout

Butler KANSAS

Map No. 14 Sec. 29 Twp. 26 R. 6EWell No. 1 WagnerIsadore Molk

Company

Contractor

COMPLETED

NE SE SW

Ft. from N. Line

990 Ft. from S. Line330 Ft. from E. Line

Ft. from W. Line

GARDEN POOL

SECTION PLAT

	0		

Location _____

Rig up _____

Drilling and Remarks:

2000 acidLOT 75
(EST.)

RECORD

Cased 5 in., 2758 ft.Sand MISS 2758

Gas _____

Oil _____

Total Depth 2768

PRODUCTION

1st 24 hrs. Nat. _____

1st 24 hrs. after shot _____

Gas _____ Cu. Ft.

Dry Hole _____

Abandoned _____

Date

FEB 8 1939

Scout

H.D.H.
By Paul