

KANSAS


FORM 51 5M 1-42 PETROL

Sedgwick

Section 22 Township 25 Range 1-E

Well No. #1 Sunnydale

Company San Springer

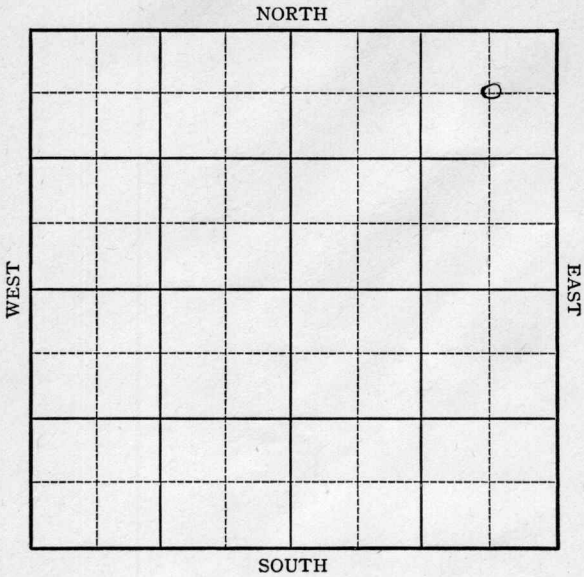

Sec. 22 Twp. 25 R. 1-E

Well No. #1 Sunnydale Farm

Sam Springer Company


Miscellaneous

660 Ft. from N. Line

_____ Ft. from S. Line

660 Ft. from E. Line

_____ Ft. from W. Line

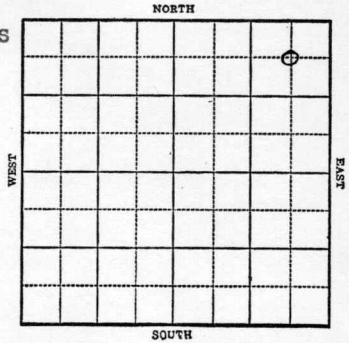

1943

R E P O R T

4/7

8" @ 70'
 Drlg. 2138'
 Sand 2138-2180
 T.D. 2180'
 D&A No shows

FIRST REPORT



ABANDONED

Sedgwick **KANSAS**

Map No. 13 Sec. 22 Twp. 25 R. 1E

Well No. 1 Sunnydale

Sam Springer Company

FIRST REPORT Contractor

C NE NE **ABANDONED**

SECTION PLAT

660 Ft. from N. Line

_____ Ft. from S. Line

660 Ft. from E. Line

_____ Ft. from W. Line

			o

MISCELLANEOUS

Location _____

Rig up _____

Drilling and Remarks:

8"-70'

Dr1g. 2138'

Sand 2138-2180

D & A

No shows

RECORD

Cased _____ in., _____ ft.

Sand _____

Gas _____

Oil _____

Total Depth 2180

PRODUCTION

1st 24 hrs. Nat. _____

1st 24 hrs. after shot _____

Gas _____ Cu. Ft.

Dry Hole _____

Abandoned _____

Date

APR 7 1943 19

S. J. LEWIS Scout