


Map No. _____ Sec. 36 Twp. 25 R. 8Well No. 2 Ladd FarmDerby & Marshall Company

NORTH

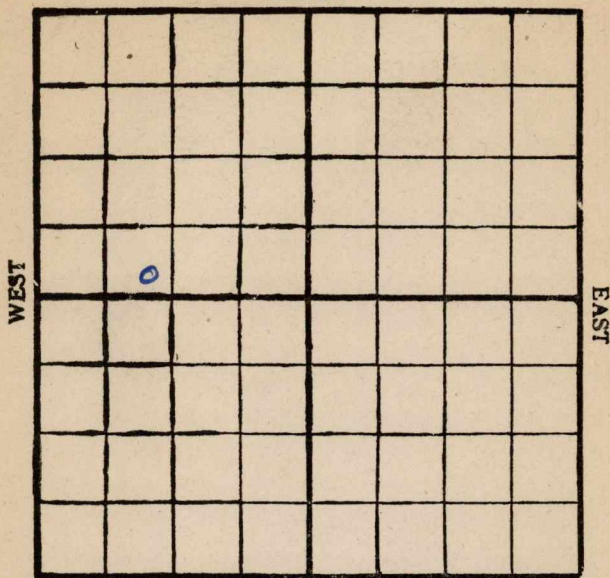

SOUTH

Location _____

Rig Up _____

Drilling Remarks:

Drilling Remarks:

RECORD

Cased _____ in. _____ ft.

Sand _____

Gas _____

Oil _____

Total Depth _____

PRODUCTION

1st 24 hrs. Nat. _____

1st 24 hrs. after shot _____

Gas _____ cu. ft.

Dry Hole _____

Abandoned _____

Map No. K 15 Sec. 36 Twp. 25 R. 8
Well No. 2 Ladd
Herby & Marshall Company
Contractor

NORTH

WEST

EAST

FIRST REPORT

300-5

SOUTH

1020-W

Location _____

Rig up ☒

Drilling and Remarks:

RECORD

Cased _____ in., _____ ft.

Sand _____

Gas _____

Oil _____

Total Depth _____

PRODUCTION

1st 24 hrs. Nat. _____

1st 24 hrs. after shot _____

Gas _____ Cu. Ft.

Dry Hole _____

Abandoned _____

Date

11/27 1918 Cyle Scout

Map No. K15 Sec. 36 Twp. 25 R. 8Well No. 2 LaddHerby & Marshall Company

Contractor

NORTH

WEST

EAST

SOUTH

300.3

1020 - W

Location _____

Rig up ☒ _____

Drilling and Remarks:

RECORD

Cased _____ in., _____ ft.

Sand _____

Gas _____

Oil _____

Total Depth _____

PRODUCTION

1st 24 hrs. Nat. _____

1st 24 hrs. after shot _____

Gas _____ Cu. Ft.

Dry Hole _____

Abandoned _____

Date

12/2 1918 Pyle Scout

Contractor

WEST

EAST

SOUTH

300-S

1020 W

Location _____

Cased _____ in., _____ ft.

Rig up

Sand_____

Drilling and Remarks:

Gas _____

Oil _____

Total Depth.....

PRODUCTION

1st 24 hrs. Nat.

1st 24 hrs. after shot-----

Gas.....Cu. Ft.

Dry Hole

Abandoned_____

Date _____

H. B.


191

Scout

Map No. K15 Sec. 36 Twp. 25 R. 8
 Well No. 2 Ladd
Herby & Marshall Company
 Contractor

NORTH

WEST

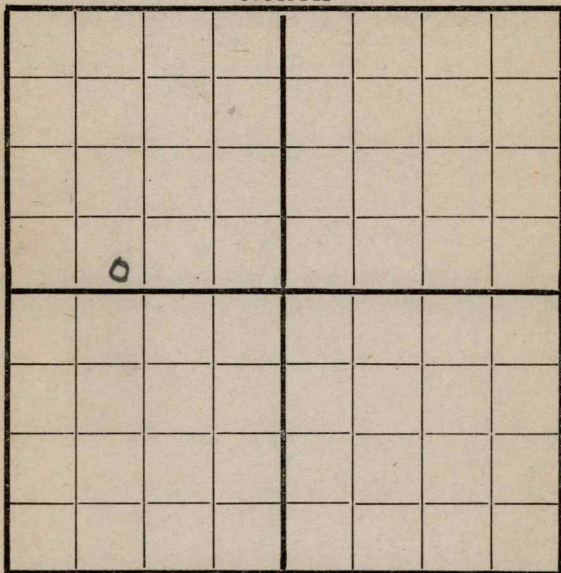

EAST

300-5

SOUTH

1020 W

Location _____

Rig up: _____

Drilling and Remarks:

Spudding

RECORD

Cased _____ in., _____ ft.

Sand _____

Gas _____

Oil _____

Total Depth _____

PRODUCTION

1st 24 hrs. Nat. _____

1st 24 hrs. after shot _____

Gas _____ Cu. Ft.

Dry Hole _____

Abandoned _____

Date

12/17

191

Pyle


Scout

Map No. N 15 Sec. 36 Twp. 25 R. 8Well No. 2 Ladd
Herby T Marshall Company
Contractor

NORTH

WEST

EAST

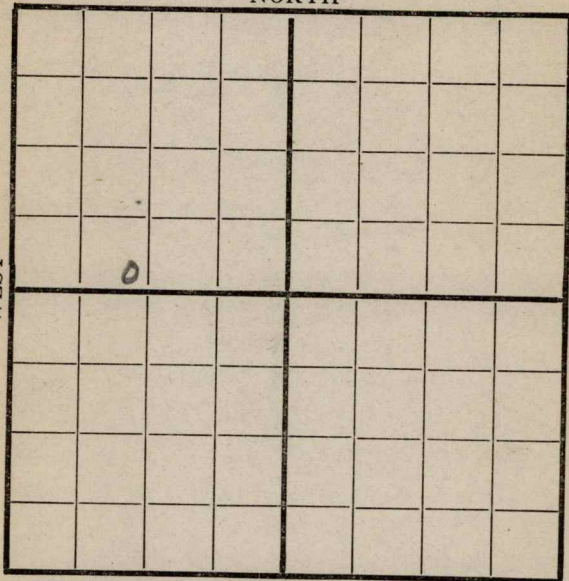

300-S

SOUTH

1020-W

Location _____

Rig up _____

Drilling and Remarks:

Spudded
@
S. 10.

RECORD

Cased _____ in., _____ ft.

Sand _____

Gas _____

Oil _____

Total Depth _____

PRODUCTION

1st 24 hrs. Nat. _____

1st 24 hrs. after shot _____

Gas _____ Cu. Ft.

Dry Hole _____

Abandoned _____

Date

12/28 191 *8* **Pyle** Scout

Map No. 115 Sec. 36 Twp. 25 R. 8.

Well No. 2 Ladd

Herby T Marshall Company

Contractor

NORTH

WEST

EAST

SOUTH

300-S

1020-W

Location _____

Rig up

Drilling and Remarks:

D. W. C.

500'

RECORD

Cased _____ in., _____ ft.

Sand_____

Gas -----

Oil_____

Total Depth.....

PRODUCTION

1st 24 hrs. Nat. -----

1st 24 hrs. after shot-----

Gas.....Cu. Ft.

Dry Hole

Abandoned_____

Date _____

Jan 7 1919

Pyle


Scout

Map No. K16 Sec. 36 Twp. 25 R. 8Well No. 2 Ladd
Derby & Marshall Company
Contractor

NORTH

WEST

EAST

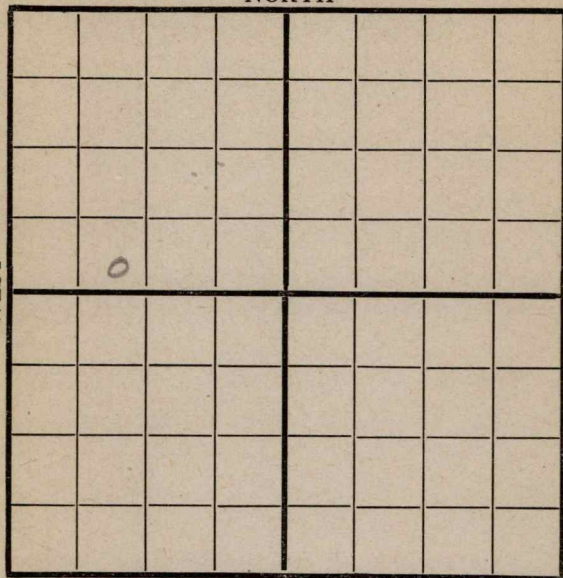

1020 W

SOUTH 300 S

Location _____

Rig up _____

Drilling and Remarks:

700

RECORD

Cased _____ in., _____ ft.

Sand _____

Gas _____

Oil _____

Total Depth _____

PRODUCTION

1st 24 hrs. Nat. _____

1st 24 hrs. after shot _____

Gas _____ Cu. Ft.

Dry Hole _____

Abandoned _____

Date

Jan 23 1919

Pyle

Scout

Map No. K16 Sec. 36 Twp. 25^S R. 8^EWell No. 2 Ladd
Durby & Marshall Company
Contractor

NORTH

WEST

EAST



SOUTH

1020 W

300 S

Location _____

Rig up _____

Drilling and Remarks:

Shot 140 gts

RECORD

Cased _____ in., _____ ft.

Sand _____

Gas _____

Oil 2337 - 2384

Total Depth _____

PRODUCTION

1st 24 hrs. Nat. _____

1st 24 hrs. after shot 40 bbls

Gas _____ Cu. Ft.

Dry Hole _____

Abandoned _____

Date

3/261919Pyle

Scout

Map No. K15 Sec. 36 Twp. 25 R. 8Well No. 2 LaddDerby & Marshall Company

Contractor

NORTH



SOUTH

Location _____

Rig up _____

Drilling and Remarks:

Shot 140 qts
 This well made
 40 bbls for
 two days but
 pumped off now
 pumping water

RECORD

Cased _____ in., _____ ft.

Sand 2327 - 2384

Gas _____

Oil _____

Total Depth _____

PRODUCTION

1st 24 hrs. Nat. _____

1st 24 hrs. after shot _____

Gas _____ Cu. Ft.

Dry Hole _____

Abandoned _____

Date

Mar 4 1919Tyler Scout