

Sedgwick


Map No. **KANSAS** Sec. 13 Twp. 27 R. 15

Well No. 1-Dr Bsell Farm _____
National Refy Company

NORTH

WEST

EAST

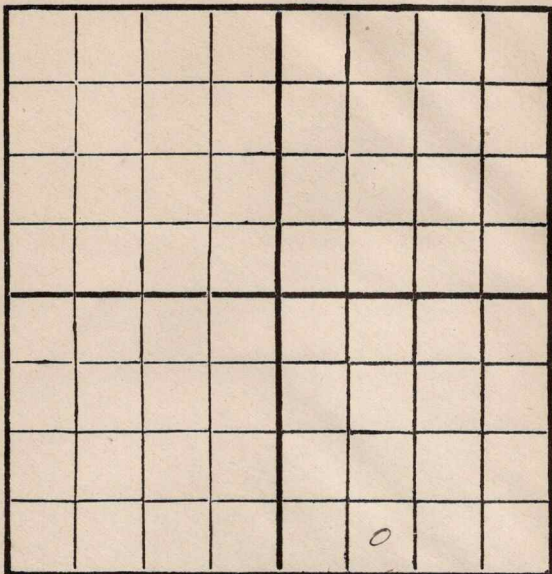

SOUTH

Location _____
Drilling Remarks _____

Rig Up _____
Drilling Remarks _____

RECORD

PRODUCTION

Cased _____ in. _____ ft.
Sand _____
Gas _____
Oil _____
Total Depth _____

1st 24 hrs. Nat. _____
1st 24 hrs. after shot _____
Gas _____ cu. ft. _____
Dry Hole _____
Abandoned _____

Map No. **KANSAS** Sec. 1 Twp. 27 R. 1E

Well No. 1-Dr Sull Farm

National Refy Company

NORTH

WEST

EAST

SOUTH

Ft. from N. Line

330 Ft. from S. Line

Ft. from E. Line

990 Ft. from W. Line

1930

Date

REPORT

Date	REPORT
10/29	Bldg. rig
11/5	Spud 170'
11/2	h. Orlg. 835'
11/19	" 1500'
11/25	" 2030'
12/3	" 2550'
12/10	" 2756'
12/17	Cly out 2990
12/23	Top Miss. 3005
	Orlg 3085
12/30	" 3260
1931	
1/7	Melcor 3358-72 HFW
	T.D. 3372
	T.D. 3412
	Dry & Abandon

Map No. **KANSAS** Sec. 1 Twp. 27 R. 15

Well No. 1 Dr. Grall

National Ref. Company

Contractor

SECTION PLAT

..... Ft. from N. Line

330 Ft. from S. Line

..... Ft. from E. Line

990 Ft. from W. Line

FIRST REPORTS

Location.....

Rig up.....

Drilling and Remarks:

Building rig

RECORD

Cased..... in., ft.

Sand.....

Gas.....

Oil.....

Total Depth.....

PRODUCTION

1st 24 hrs. Nat.....

1st 24 hrs. after shot.....

Gas..... Cu. Ft.

Dry Hole.....

Abandoned.....

Date

OCT 29 1930

S. J. LEWIS

Scout

Map No. **KANSAS** Sec. 1 Twp. 27 R. 1E

Well No. 1 Dr Groll

National Ref. Company

Contractor

SECTION PLAT

..... Ft. from N. Line

330 Ft. from S. Line

..... Ft. from E. Line

990 Ft. from W. Line

ABANDONED

Location.....

Rig up.....

Drilling and Remarks:

Well 3358-72
NFW

RECORD

Cased.....in.,ft.

Sand.....

Gas.....

Oil.....

Total Depth 3712

PRODUCTION

1st 24 hrs. Nat.....

1st 24 hrs. after shot.....

Gas.....Cu. Ft.

Dry Hole.....

Abandoned.....

Date

JAN 7 1931

192.....

S. J. LEWIS

Scout