

Sedgwick


Form 51-5M-2-29-34708

Map No. **KANSAS** Sec. *24* Twp. *25* R. *1E*

Well No. *1 - Kuske* Farm

Producers OK Company

NORTH

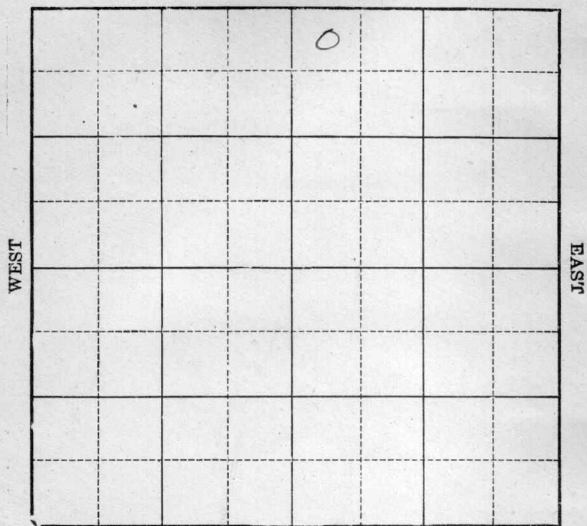

SOUTH

Location _____

Drilling Remarks _____

Rig Up _____

Drilling Remarks _____

RECORD

Cased _____ in. _____ ft.

Sand _____

Gas _____

Oil _____

Total Depth _____

PRODUCTION

1st 24 hrs. Nat. _____

1st 24 hrs. after shot _____

Gas _____ cu. ft.

Dry Hole _____

Abandoned _____

Sedgwick

Map No. KANSAS Sec. 24 Twp. 25 R. 1E


Well No. 1 - Kuske Farm
Producers O&R Company

330 Ft. from N. Line

_____ Ft. from S. Line

_____ Ft. from E. Line

330 Ft. from W. Line

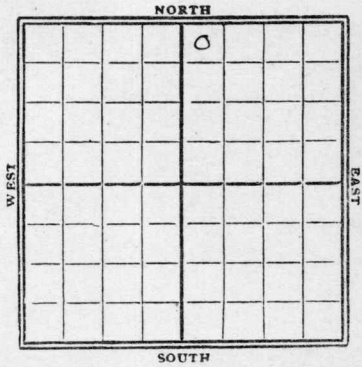

1929

Date

REPORT

Date	REPORT
<i>4/24</i>	<i>Location</i>
<i>5/11</i>	<i>Rig</i>
<i>5/8</i>	<i>Rigging up</i>
<i>5/15</i>	<i>perlg 650'</i>
<i>5/22</i>	<i>" 1330'</i>
<i>5/29</i>	<i>" 1800'</i>
<i>6/5</i>	<i>" 2525'</i>
<i>6/12</i>	<i>" 2590'</i>
<i>6/19</i>	<i>" 2760'</i>
<i>7/1</i>	<i>Sand 3013-17 filled 3000' oil in 30 minutes</i>
<i>7/2</i>	<i>slipping over about 3 bbls per hr 42.5 gravity</i>
<i>7/10</i>	<i>Burgess 3013-17 T.D. 3017 swab 356 bbl 18hr Comp</i>

Map No. 13 **KANSAS** Sec. 24 Twp. 25 R. 12

Well No. 1 Tuske

Producers Oil Ref Company

Contractor

SECTION PLAT

330 Ft. from N. Line

..... Ft. from S. Line

..... Ft. from E. Line

330 Ft. from W. Line

		o	

FIRST REPORTS

Location ✓

Rig up

Drilling and Remarks:

RECORD

Cased..... in., ft.

Sand.....

Gas.....

Oil.....

Total Depth.....

PRODUCTION

1st 24 hrs. Nat.....

1st 24 hrs. after shot.....

Gas..... Cu. Ft.

Dry Hole.....

Abandoned.....

Date

APR 24 1929

192

S. J. LEWIS

Scout

Map No. 13 **KANSAS** Sec. 24 Twp. 25 R. 1E

Well No. 1 Kuske

Producers Oil Ref. Company
Contractor

SECTION PLAT

330 Ft. from N. Line
_____ Ft. from S. Line
_____ Ft. from E. Line
330 Ft. from W. Line

		0	

COMPLETED

Location _____

Rig up _____

Drilling and Remarks:

Burgess sand
3018-17
Swath 3568 ft
18 hrs.

RECORD

Cased _____ in., _____ ft.

Sand _____

Gas _____

Oil _____

Total Depth 3017

PRODUCTION

1st 24 hrs. Nat. _____

1st 24 hrs. after shot _____

Gas _____ Cu. Ft.

Dry Hole _____

Abandoned _____

Date

JUL 10 1929

S. J. LEWIS Scout