

Form 51-5M-2-29-34703

Sedgwick

Map No. **KANSAS** Sec. *24* Twp. *25* R. *1E*

Well No. *1- H. Tuske* Farm


Barnsdall Oil Company

NORTH

WEST

EAST

SOUTH

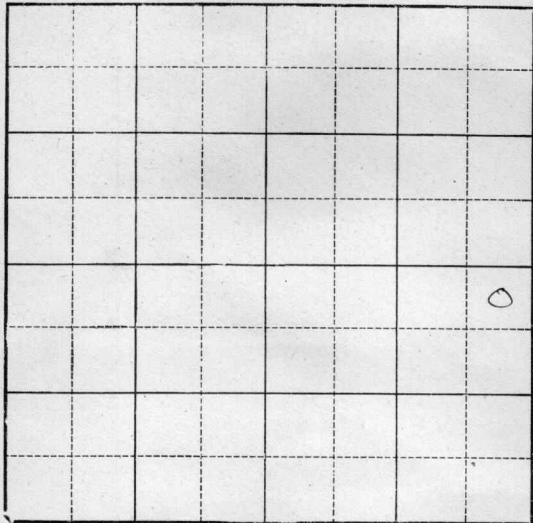

Location _____

Drilling Remarks _____

RECORD

Cased _____ in. _____ ft.

Sand _____

Gas _____

Oil _____

Total Depth _____

Rig Up _____

Drilling Remarks _____

PRODUCTION

1st 24 hrs. Nat. _____

1st 24 hrs. after shot _____

Gas _____ cu. ft.

Dry Hole _____

Abandoned _____


Sedgwick
 Map No. KANSAS Sec. 24 Twp. 25 R. 1E
 Well No. 1- F. Tusk Farm
Barnsdall Oil Company

330 Ft. from N. Line

_____ Ft. from S. Line

330 Ft. from E. Line

_____ Ft. from W. Line

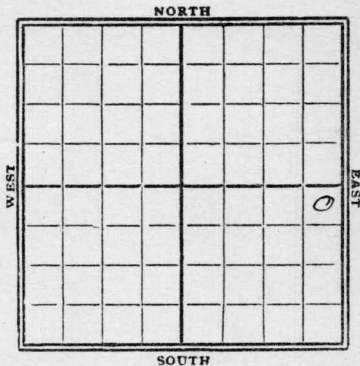

1929

Date	REPORT
3/13	Location
3/20	
3/27	Log
4/3	Rig
4/10	Spud
4/17	Depth 535'
4/24	" 1180'
5/1	" 1600'
5/8	" 2296'
5/15	2558' - U.R. 8"
5/22	U.R. 8" - 2670'
5/29	Depth 2815'
6/5	6" - 3004 HFW 3028 - U.R. 6"
6/12	Depth 3150'
6/19	Depth 3385 Base Miss 3346'
6/26	3395 Reblldg Rig
7/3	Rig up
7/17	Top Miss line 3475'
	HFW at 3500'
7/24	Log took 3500'
7/31	
8/17	Depth 3650'

8/14 - Wily 3690

8/21 above

8/21- TD. 3700'

Abandoned

Map No. KANSAS Sec. 24 Twp. 25 R. 1E

Well No. 1 H. Kump

Barnwell Oil Company

Contractor

SECTION PLAT

			0

330 Ft. from N. Line

..... Ft. from S. Line

330 Ft. from E. Line

..... Ft. from W. Line

FIRST REPORTS

Location ✓

Rig up

Drilling and Remarks:

RECORD

Cased in., ft.

Sand

Gas

Oil

Total Depth

PRODUCTION

1st 24 hrs. Nat.

1st 24 hrs. after shot

Gas Cu. Ft.

Dry Hole

Abandoned

Date

MAR 13 1929

192.....

S. J. LEWIS

Scout

Map No. **KANSAS** Sec. *24* Twp. *25* R. *15*

Well No. *1 N. Huska*

Barnsdall Oil Company

Contractor

SECTION PLAT

820 Ft. from N. Line

..... Ft. from S. Line

820 Ft. from E. Line

..... Ft. from W. Line

			0

ABANDONED

Location.....

Rig up.....

Drilling and Remarks:

RECORD

Cased..... in., ft.

Sand.....

Gas.....

Oil.....

Total Depth *8700*

PRODUCTION

1st 24 hrs. Nat.....

1st 24 hrs. after shot.....

Gas..... Cu. Ft.

Dry Hole.....

Abandoned.....

Date

AUG 21 1929

S. J. LEWIS

Scout