


Map No. _____ Sec. 31 Twp. 25 R. 7

Well No. 1 Galiaferro Farm _____
Central State Oil Company

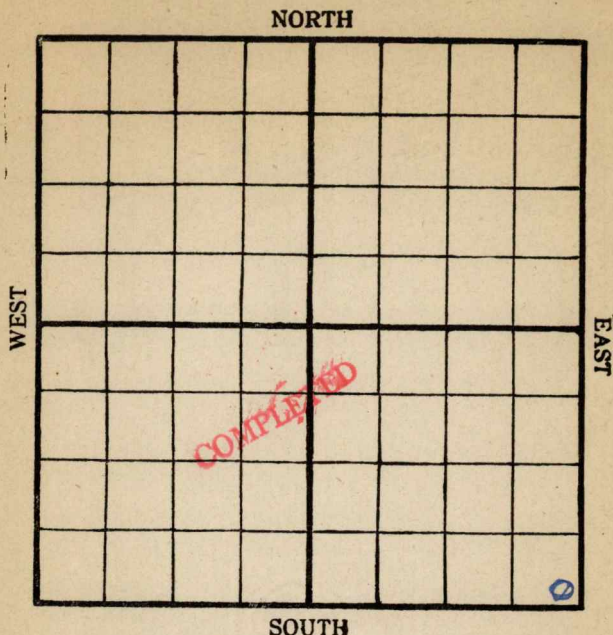

Location _____

Rig Up _____

Drilling Remarks:

Drilling Remarks:

RECORD

PRODUCTION

Cased _____ in. _____ ft.

1st 24 hrs. Nat. _____

Sand _____

1st 24 hrs. after shot _____

Gas _____

Gas _____ cu. ft.

Oil _____

Dry Hole _____

Total Depth _____

Abandoned _____

Map No. K15 Sec. 31 Twp. 25^S R. 7^EWell No. 1 - Taliaferro
Central States Oil Company

Contractor _____

NORTH

WEST

EAST

SOUTH

Location

300 N

Rig up

300 W

Drilling and Remarks:

RECORD

Cased _____ in., _____ ft.

Sand _____

Gas _____

Oil _____

Total Depth _____

PRODUCTION

1st 24 hrs. Nat. _____

1st 24 hrs. after shot _____

Gas _____ Cu. Ft.

Dry Hole _____

Abandoned _____

Date

8/311918

Pyle

Scout

Map No. K15 Sec. 31 Twp. 25 R. 7
 Well No. 1 Talioferro
Central State Oil- Company
 Contractor

NORTH							
WEST							
SOUTH							

Location 300 S-E

Rig up ☒

Drilling and Remarks:

RECORD

Cased _____ in., _____ ft.

Sand _____

Gas _____

Oil _____

Total Depth _____

PRODUCTION

1st 24 hrs. Nat. _____

1st 24 hrs. after shot _____

Gas _____ Cu. Ft.

Dry Hole _____

Abandoned _____

Date

10/24 1918

Pyle

Scout

Map No. *K 15* Sec. *31* Twp. *25* R. *7*
Well No. *1 Talioferro*
Central States Oil Company
Contractor

NORTH

WEST

EAST

SOUTH

300 S-E

Location _____

Rig up.....

Drilling and Remarks:

RECORD

Cased _____ in., _____ ft.

Sand.....

Gas -----

Oil

Total Depth.....

PRODUCTION

1st 24 hrs. Nat. -----

1st 24 hrs. after shot.....

Gas_____Cu. Ft.

Dry Hole

Abandoned.....

Date _____

Jan 22 1919

Pyle

Scout

Map No. K12 Sec. 31 Twp. 25 R. 7

Well No. 1 Valeriano

Call No. 1 *Central States Oil* Company

Contractor

NORTH

WEST

EAST

SOUTH

300 S-E

RECORD

Location _____

Cased-----in., -----ft.

Rig up. ✓

Sand_____

Drilling and Remarks:

Gas -----

Oil _____

Total Depth.....

PRODUCTION

1st 24 hrs. Nat. -----

1st 24 hrs. after shot_____

Gas.....Cu. Ft.

Dry Hole.....

Abandoned.....

Date _____

3/7

191

Pyle

Scout


Map No. 1515 Sec. 31 Twp. 25^s R. 7^EWell No. 1 TulipCentral States Oil Company

Contractor _____

NORTH

WEST

EAST

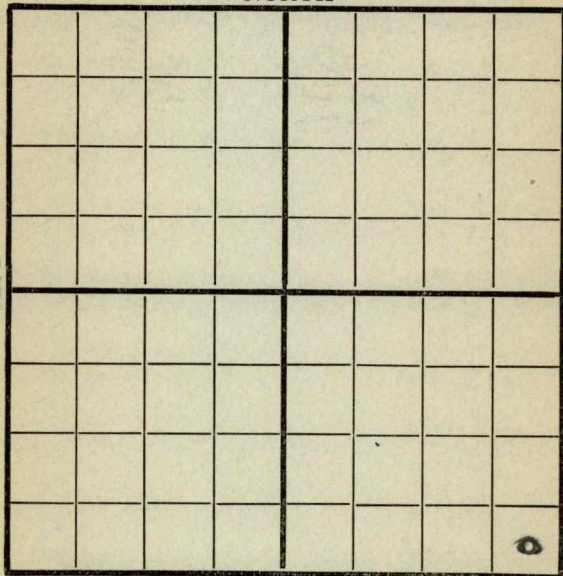

3005-E SOUTH

Location _____

Rig up ☒

Drilling and Remarks:

RECORD

Cased _____ in., _____ ft.

Sand _____

Gas _____

Oil _____

Total Depth _____

PRODUCTION

1st 24 hrs. Nat. _____

1st 24 hrs. after shot _____

Gas _____ Cu. Ft.

Dry Hole _____

Abandoned _____

Date

3/15 1919 Cyler Scout

Map No. K15 Sec. 31 Twp. 25 R. 7
Well No. 1 Talioferro
Central States Pet Company
Contractor

NORTH

WEST

EAST

300' S-E SOUTH

Location _____

Rig up

Drilling and Remarks:

RECORD

Cased-----in., -----ft.

Sand _____

Gas _____

Oil _____

Total Depth.....

PRODUCTION

1st 24 hrs. Nat. -----

1st 24 hrs. after shot-----

Gas.....Cu. Ft.

Dry Hole

Abandoned_____

Date _____

$\frac{3}{22}$ 191 9.


Pyle

Scout

Map No. K 15 Sec. 31 Twp. 25 R. 7
 Well No. 1 Talioferro
Central States Oil Company

Contractor

NORTH

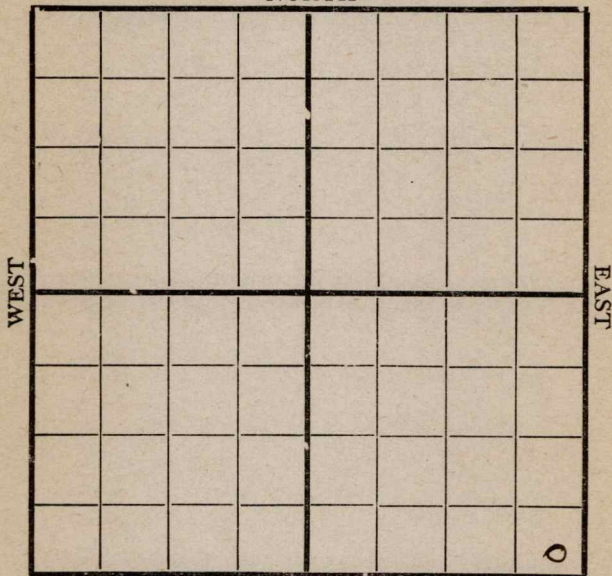

300 S-E SOUTH

Location

Rig up ☒

Drilling and Remarks:

RECORD

Cased _____ in., _____ ft.

Sand _____

Gas _____

Oil _____

Total Depth _____

PRODUCTION

1st 24 hrs. Nat. _____

1st 24 hrs. after shot _____

Gas _____ Cu. Ft.

Dry Hole _____

Abandoned _____

Date

191

9

Pyle Scout

Map No. *K15* Sec. *31* Twp. *25* R. *7*
Well No. *10 Talisferro*
Central States Petroleum Company
Contractor

NORTH

WEST

EAST

SOUTH

300 S-E

Location _____

Rig up ✓

Drilling and Remarks:

RECORD

Cased _____ in., _____ ft.

Sand _____

Gas _____

Oil _____

Total Depth_____

PRODUCTION

1st 24 hrs. Nat. -----

1st 24 hrs. after shot.....

Gas.....Cu. Ft.

Dry Hole.....

Abandoned.....

Date _____

191

Pyle


Scout

Map No. K 15 Sec. 31 Twp. 25 R. 7
 Well No. 1 Taliopferro
Central States Oil Company
 Contractor

NORTH

WEST

EAST

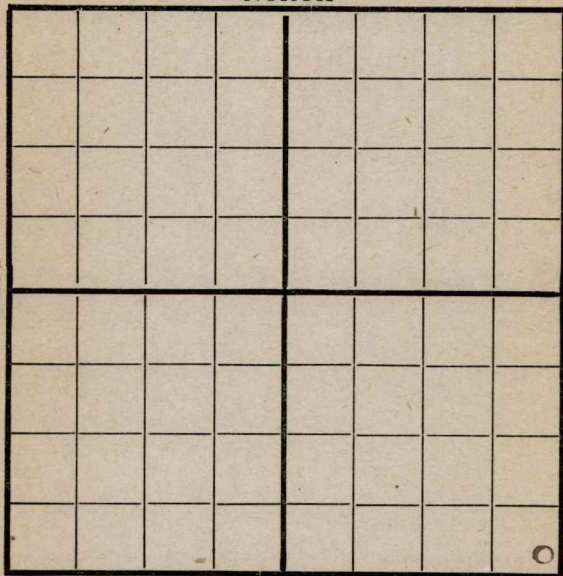

300' ~~EW~~ SOUTH S-E

Location _____

Rig up ☒ _____

Drilling and Remarks:

RECORD

Cased _____ in., _____ ft.

Sand _____

Gas _____

Oil _____

Total Depth _____

PRODUCTION

1st 24 hrs. Nat. _____

1st 24 hrs. after shot _____

Gas _____ Cu. Ft.

Dry Hole _____

Abandoned _____

Date

Pyle


191

Scout

Map No. _____ Sec. 31 Twp. 25 R. 7
 Well No. 10 Taliaferro Farm _____
Central State Oil Company

NORTH

WEST

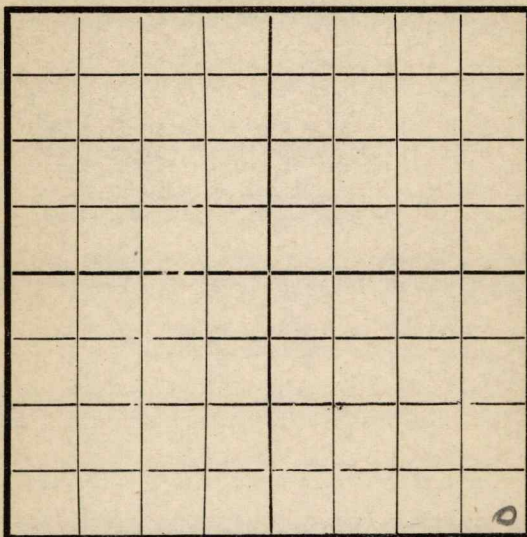

EAST

SOUTH

Location ✓

Rig Up _____

Drilling and remarks _____

RECORD

Cased _____ in. _____ Ft.

Sand _____

Gas _____

Oil _____

Total Depth _____

PRODUCTION

1st 24 hrs. Nat. _____

1st 24 hrs. after shot _____

Gas _____ Cu. Ft.

Dry Hole _____

Abandoned _____

Date

4/16, 1918 Cyber Scout


Map No. K 15 Sec. 31 Twp. 25 R. 7
 Well No. 1 Tailor
Central States Oil Company

Contractor _____

NORTH

WEST

EAST

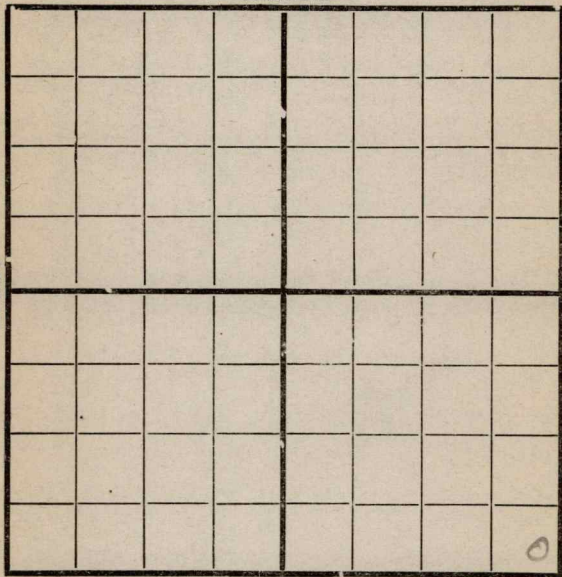

SOUTH

300 S-E

Location _____

Rig up ☒

Drilling and Remarks:

RECORD

Cased _____ in., _____ ft.

Sand _____

Gas _____

Oil _____

Total Depth _____

PRODUCTION

1st 24 hrs. Nat. _____

1st 24 hrs. after shot _____

Gas _____ Cu. Ft.

Dry Hole _____

Abandoned _____

Date

Pyle

191

9

Scout

4/18


Map No. K 15 Sec. 31 Twp. 25 R. 7Well No. 1 GalioferroCentral States Oil Company

Contractor _____

NORTH

WEST

EAST

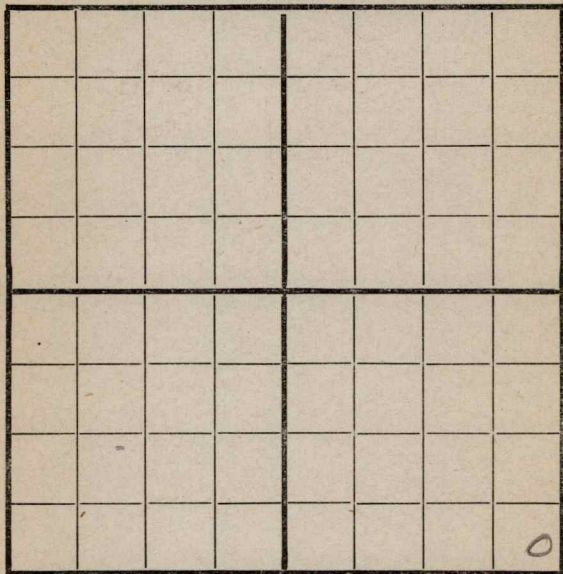

300 S-E SOUTH

Location _____

Rig up ☒ _____

Drilling and Remarks:

RECORD

Cased _____ in., _____ ft.

Sand _____

Gas _____

Oil _____

Total Depth _____

PRODUCTION

1st 24 hrs. Nat. _____

1st 24 hrs. after shot _____

Gas _____ Cu. Ft.

Dry Hole _____

Abandoned _____

Date

Pyle

Scout

4/24 1919


Map No. K15 Sec. 31 Twp. 25 R. 7Well No. 1 Talioferro
Central States Oil Company

Contractor _____

NORTH

WEST

EAST

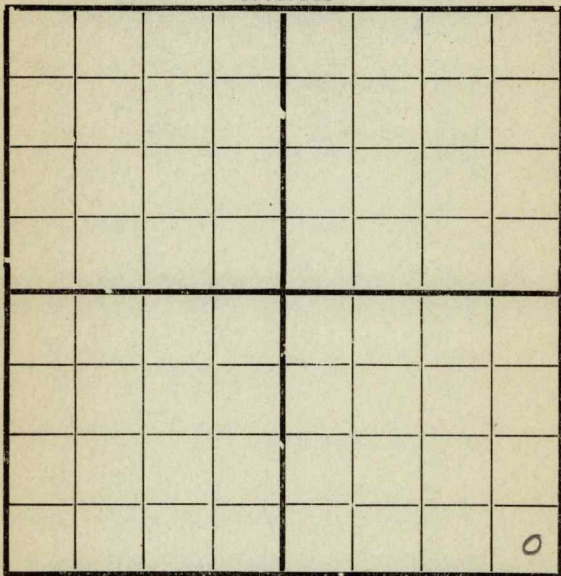

300 S-E SOUTH

Location _____

Rig up ☒

Drilling and Remarks: _____

RECORD

Cased _____ in., _____ ft.

Sand _____

Gas _____

Oil _____

Total Depth _____

PRODUCTION

1st 24 hrs. Nat. _____

1st 24 hrs. after shot _____

Gas _____ Cu. Ft.

Dry Hole _____

Abandoned _____

Date

5/7

191

9

Pyle

Scout

Contractor

WEST

EAST

SOUTH

Location _____

Rig up ✓

Drilling and Remarks:

RECORD

Cased-----in., -----ft.

Sand _____

Gas -----

Oil _____

Total Depth.....

PRODUCTION

1st 24 hrs. Nat. -----

1st 24 hrs. after shot_____

Gas.....Cu. Ft.

Dry Hole.....

Abandoned.....

Date _____

191

Scout

Map No. K15 Sec. 31 Twp. 25 R. 7Well No. 1 Talioferro
Central States Oil Company

Contractor

NORTH

WEST

EAST

300 S-E SOUTH

Location

Rig up ☒

Drilling and Remarks:

RECORD

Cased _____ in., _____ ft.

Sand _____

Gas _____

Oil _____

Total Depth _____

PRODUCTION

1st 24 hrs. Nat. _____

1st 24 hrs. after shot _____

Gas _____ Cu. Ft.

Dry Hole _____

Abandoned _____

Date

1919

Pyle

Scout

Map No. K15 Sec. 31 Twp. 25 R. 7
Well No. 1 Galioferro
Central States Ref. Company
Contractor

NORTH

WEST

EAST

SOUTH

300 S-E

6

Location _____

Rig up.....

Drilling and Remarks:

RECORD

Cased-----in., -----ft.

Sand_____

Gas -----

Oil.....

Total Depth_____

PRODUCTION

1st 24 hrs. Nat. -----

1st 24 hrs. after shot-----

Gas.....Cu. Ft.

Dry Hole_____

Abandoned_____

Date _____


191.9

Pyle

Scout

Map No. K 15 Sec. 31 Twp. 25 R. 7
Well No. 1 Talioferro
Central States Pub Company
Contractor

NORTH

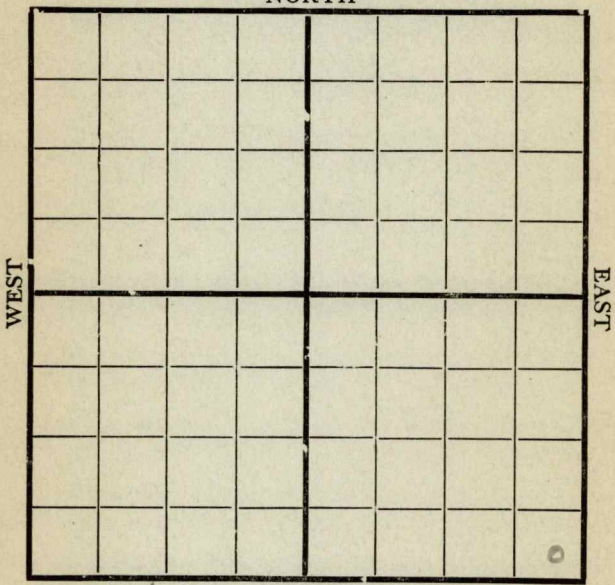

300' SE SOUTH

Location _____
Rig up ☒
Drilling and Remarks:

RECORD

Cased _____ in., _____ ft.
Sand _____
Gas _____
Oil _____
Total Depth _____

PRODUCTION

1st 24 hrs. Nat. _____
1st 24 hrs. after shot _____
Gas _____ Cu. Ft.
Dry Hole _____
Abandoned _____

Date

6/6 1919 Pyle Scout


Map No. K15 Sec. 31 Twp. 25 R. 7Well No. 1 Talioferro
Central States Oil Company

Contractor _____

NORTH

WEST

EAST

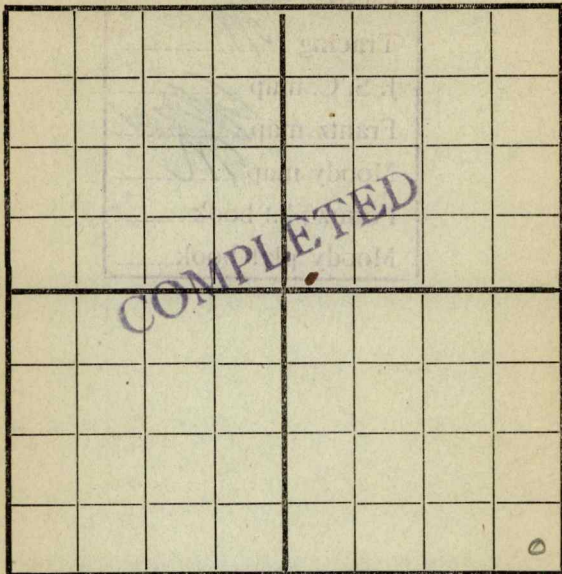

300 S-E SOUTH

Location _____

Rig up ☒ _____

Drilling and Remarks:

*Will drop
until well
is started*

RECORD

Cased _____ in., _____ ft.

Sand _____

Gas _____

Oil _____

Total Depth _____

PRODUCTION

1st 24 hrs. Nat. _____

1st 24 hrs. after shot _____

Gas _____ Cu. Ft.

Dry Hole _____

Abandoned _____

Date

Pyle

191

9

Scout

6/13