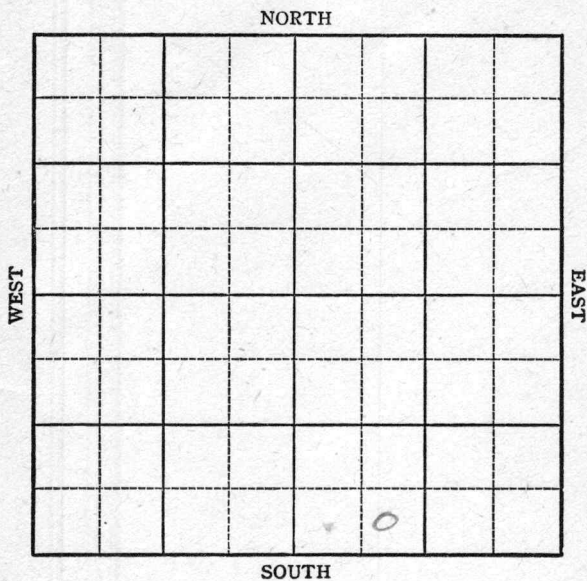


KANSAS

Butler county

Section 28 Township 26 Range 6-EWell No. #1, StraitCompany Huber etal

Sec. 28 Twp. 26 R. 6-E

Well No. #1, Strait Farm
Huber etal Company


Miscellaneous

 Ft. from N. Line

330' Ft. from S. Line

 Ft. from E. Line

990' Ft. from W. Line

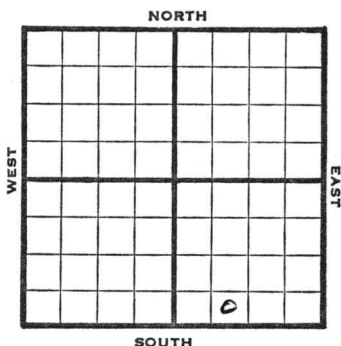

SE SW SE

1946

Elev. 1408' REPORT

12/18 Machine

1947

1/4 Mach.

1/8 "

1/15 "

1/21 "

1/30 "

2/5 "

2/12 "

2/19 "

2/26 "

3/4 Mack

3/11 "

3/18 "

3/25 "

4/2 "

OVER

4/9 Machine.
4/15 "
4/23 "
4/29 "
5/7 "
5/13 "
5/20 "
5/27 Drlg 100'
6/3 Drlg. 900'
6/10 10" @ 1621'
Drlg. 1900'
6/17 KC 2143'
8" @ 2375'
Drlg. 2575'
6/24 Drlg. 2712'
7/1 "
7/9 Viola 3211'
TD 3213'

ABANDONED

Map No. _____ Sec. 28 Twp. 26 R. 6EWell No. 1 Strait

Huber et al.


Company

FIRST REPORT

Contractor

SE SW SE

SECTION PLAT

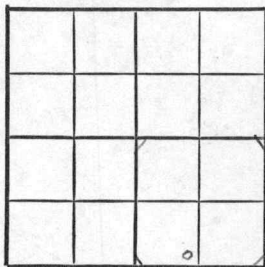

_____ Ft. from N. Line

330 Ft. from S. Line

_____ Ft. from E. Line

990 Ft. from W. Line

Butler County

Location _____

Rig up _____

Drilling and Remarks:

Machine

RECORD

Cased _____ in., _____ ft.

Sand _____

Gas _____

Oil _____

Total Depth _____

PRODUCTION

1st 24 hrs. Nat. _____

1st 24 hrs. after shot _____

Gas _____ Cu. Ft.

Dry Hole _____

Abandoned _____

Date

DEC 1 8 1946 19

S. J. LEWIS

Scout

14

Map No. 14 Sec. 28 Twp. 26 R. 6E

Well No. 1 Strait

Huber et al. Company

ABANDONED Contractor

SE SW SE


E11408
SECTION PLAT

 Ft. from N. Line

330 Ft. from S. Line

 Ft. from E. Line

990 Ft. from W. Line

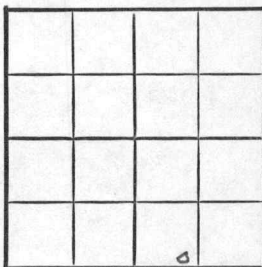

Butler County

Location

Rig up

Drilling and Remarks:

Vista 3211

RECORD

Cased in., ft.

Sand

Gas

Oil

Total Depth 3225

PRODUCTION

1st 24 hrs. Nat.

1st 24 hrs. after shot

Gas Cu. Ft.

Dry Hole

Abandoned

Date

JUL 9 1947 19 S. J. LEWIS Scout