


Section 24 Township 25 Range 1 E

Well No. # 1 Kuske

Company C. L. Carlock

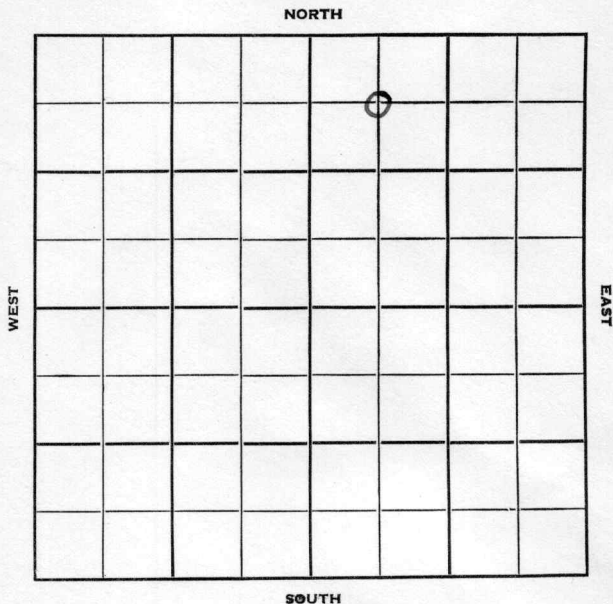

Sedgwick

KANSAS

Sec. 24 Twp. 25 R. 1E

Well No. #1 Kuske Farm

C. L. Carlock Company

Eckland Drlg. - Contr. Contractor
Kuske


660' Ft. from N. Line

Ft. from S. Line

Ft. from E. Line

660' Ft. from W. Line

C NW NE

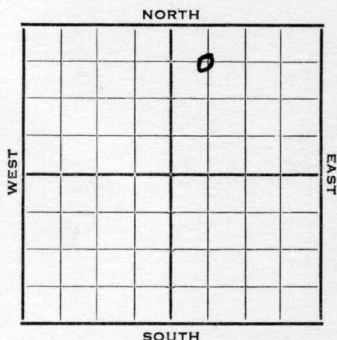

1952

Elev. 1437' REPORT

6/18

Spud 6-12-52

8" @ 126

Drlg. 2682'

7/2

Spud 6-12-52

D & A TD 3041' 8" @ 126

KC 2567' B KC 2739' Cong. 2993'

Burgess 3014' TD 3016' 5" @ 3016

DD 3041' HFW

D & A


ABANDONED

County **Sedgwick** State **Kansas**Sec. **24** (Blk.) **25** (Sur.) **1E** Map No.Operator **C. L. Carlock**Well No. **1** Farm **Kuske**Elev. Location **C NW NE****660** Ft. From **N** Line **NE****660** Ft. From **W** Line Quarter1st. Report **JUN 18 1952**

Completion

Remarks

Eckland Drlg. - Contr.Spudding Date **6-12-52**Drlg. Data **Kuske****8" @ 126 Drlg. 2682**

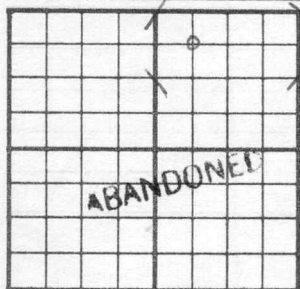County Sedgwick State KansasSec. 24 (Blk.
Twp.) 25 (Sur.
Rge.) 1E Map No.Operator C. L. CarlockWell No. 1 Farm KuskeElev. 1437 Location C NW NE660 Ft. From N Line NE660 Ft. From W Line Quarter

1st. Report

Completion JUL 2 1952Remarks Kuske PoolEckland Drlg. - Contr.Spudding Date 6-12-52Drlg. Data D & A TD 30418" @ 126 KC 2567 B KC 2739 Cong. 2993Burgess 3014 TD 3016 5" @ 3016DD 3041 HFWD & A