


Map No. _____ Sec. 32 Twp. 25 R. 7
 Well No. #1 Reece Farm
Diamond Oil Company

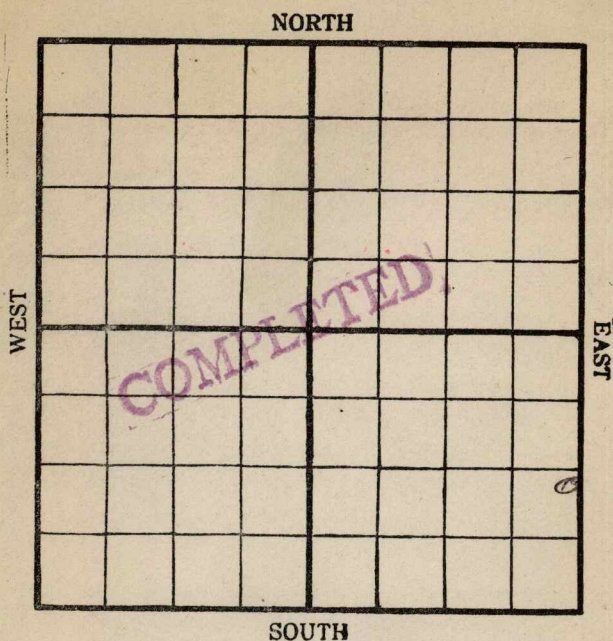

Location _____

Rig Up _____

Drilling Remarks:

Drilling Remarks:

RECORD

Cased _____ in. _____ ft.

Sand _____

Gas _____

Oil _____

Total Depth _____

PRODUCTION

1st 24 hrs. Nat. _____

1st 24 hrs. after shot _____

Gas _____ cu. ft

Dry Hole _____


Abandoned _____

Map No. K15 Sec. 32 Twp. 25 R. 7

Well No. 1 Reese Farm

Diamond Oil Company

NORTH

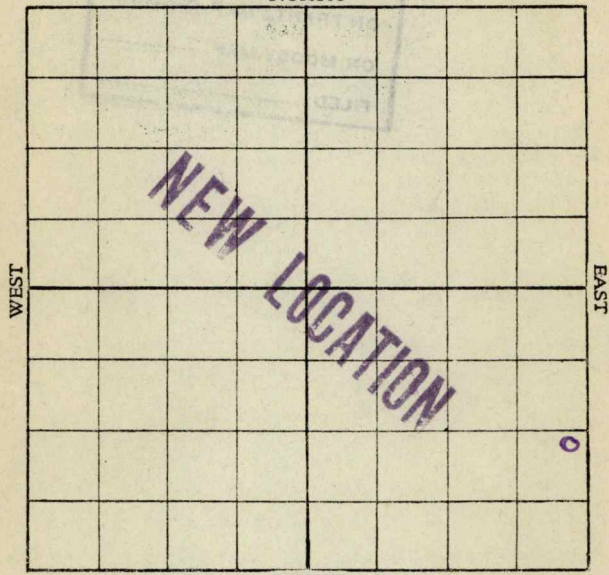

SOUTH

Location _____

Rig up ☒

Drilling and remarks:

RECORD

Cased _____ in. _____ Ft.

Sand _____

Gas _____

Oil _____

Total Depth _____

PRODUCTION

1st 24 hrs. Nat. _____

1st 24 hrs. after shot _____

Gas _____ Cu. Ft.

Dry Hole _____

Abandoned _____

Date JUN 30 1917


_____, 191____, B. J. Lewis Scout

Map No. _____ Sec. 32 Twp. 25 R. 7

Well No. 1 Ruece Farm

Diamond Oil Company

NORTH

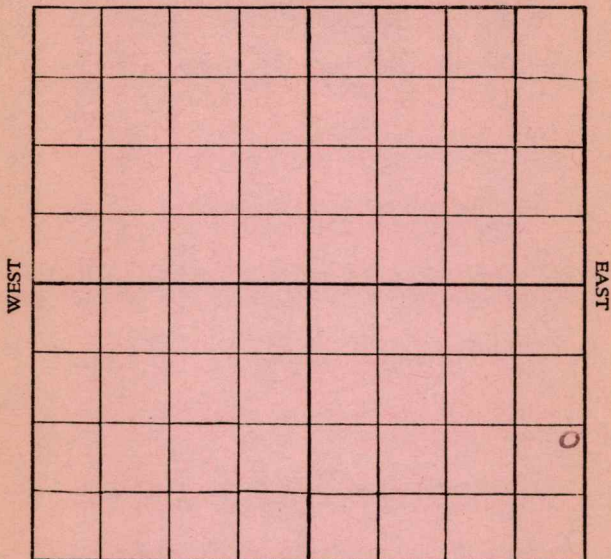

SOUTH

Location _____

Rig up ✓

Drilling and remarks:

RECORD

Cased _____ in. _____ Ft.

Sand _____

Gas _____

Oil _____

Total Depth _____

PRODUCTION

1st 24 hrs. Nat. _____

1st 24 hrs. after shot _____

Gas _____ Cu. Ft.

Dry Hole _____

Abandoned _____

Date JUL 7 1917

_____, 191____, C. T. Crocker Scout

Map No. _____ Sec. 32 Twp. 25 R. 7
 Well No. 1 Rice Farm
Diamond Oil Company
 NORTH

WEST EAST

SOUTH

Location _____
 Rig up. ☒ _____
 Drilling and remarks:

RECORD

Cased _____ in. _____ Ft.
 Sand _____
 Gas _____
 Oil _____
 Total Depth _____

PRODUCTION

1st 24 hrs. Nat. _____
 1st 24 hrs. after shot _____
 Gas _____ Cu. Ft.
 Dry Hole _____
 Abandoned _____

Date

JUL 14 1917

, 191

E. J. Crocker Scout

Map No. Sec. 32, Twp. 25, R. 7

Well No. Reece

Granville Oil Company

NORTH

SOUTH

WEST

EAST

Location

Rig up

Drilling and remarks:

RECORD

Cased.....in,Ft.

Sand

Gas

Oil

Total Depth

PRODUCTION

1st 24 hrs. Nat.....

1st 24 hrs. after shot.....

Gas.....Cu. ft.

Dry Hole

Abandoned

Date


7/17 191 7 Aug Scout

Map No. _____ Sec. 32 Twp. 25 R. 7
 Well No. 1. Reese Farm _____
Diamond Oil Company

NORTH

WEST

EAST

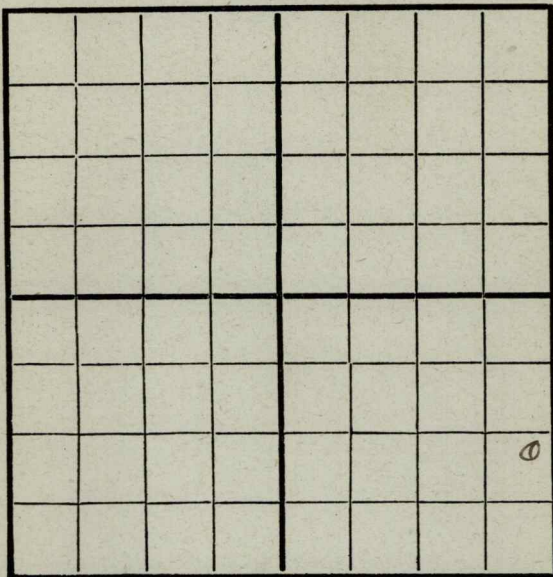

SOUTH

Location _____

Rig Up _____

Drilling and remarks _____

RECORD

Cased _____ in. _____ Ft.

Sand _____

Gas _____

Oil _____

Total Depth _____

PRODUCTION

1st 24 hrs. Nat. _____

1st 24 hrs. after shot _____

Gas _____ Cu. Ft.

Dry Hole _____

Abandoned _____

Date


7/24, 1917 Condy Scout

Map No. _____ Sec. 32 Twp. 25 R. 7
 Well No. 1 Reese Farm
Diamond Oil Company

NORTH

WEST

EAST

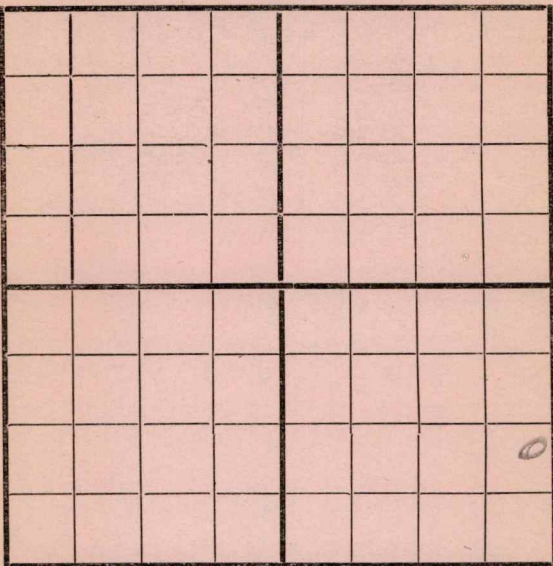

SOUTH

Location _____

Rig Up _____

Drilling and remarks _____

RECORD

Cased _____ in. _____ Ft.

Sand _____

Gas _____

Oil _____

Total Depth _____

PRODUCTION

1st 24 hrs. Nat. _____

1st 24 hrs. after shot _____

Gas _____ Cu. Ft.

Dry Hole _____

Abandoned _____


Date

8/1, 1917 Cardiff Scout

Map No. _____ Sec. 34 Twp. 45 R. 7Well No. 1. Reel Farm _____Diamond Company

NORTH

WEST

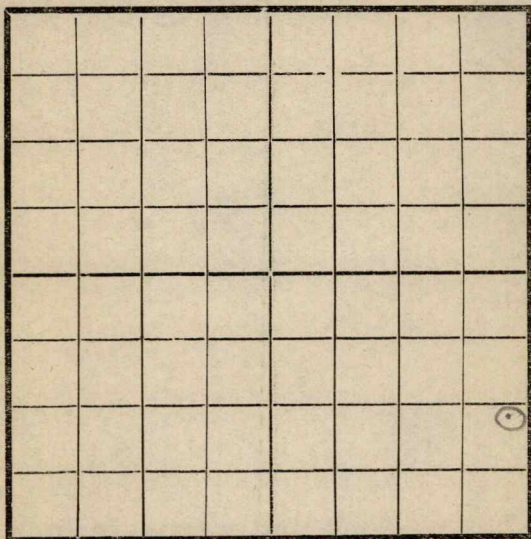

EAST

SOUTH

Location _____

Rig Up ☒ _____

Drilling and remarks _____

RECORD

Cased _____ in. _____ Ft.

Sand _____

Gas _____

Oil _____

Total Depth _____

PRODUCTION

1st 24 hrs. Nat. _____

1st 24 hrs. after shot _____

Gas _____ Cu. Ft.

Dry Hole _____

Abandoned _____

Date


8-22-1917Lantz Scout

Map No. _____ Sec. 33 Twp. 25 R. 7
 Well No. 1 Reese Farm _____
Diamond Oil Company

NORTH

WEST

EAST

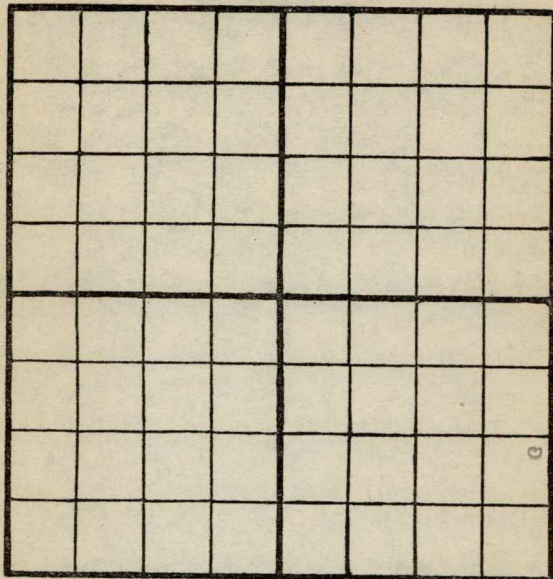

SOUTH

Location _____

Rig Up _____

Drilling and remarks

*Mining
in Tones*

RECORD

Cased _____ in. _____ Ft.

Sand _____

Gas _____

Oil _____

Total Depth _____

PRODUCTION

1st 24 hrs. Nat. _____

1st 24 hrs. after shot _____

Gas _____ Cu. Ft.

Dry Hole _____

Abandoned _____


Date

9/19, 1917 Cardiff Scout

Map No. _____ Sec. 32 Twp. 25 R. 7Well No. 1 Pace Farm _____
Dimmick Company

NORTH

WEST

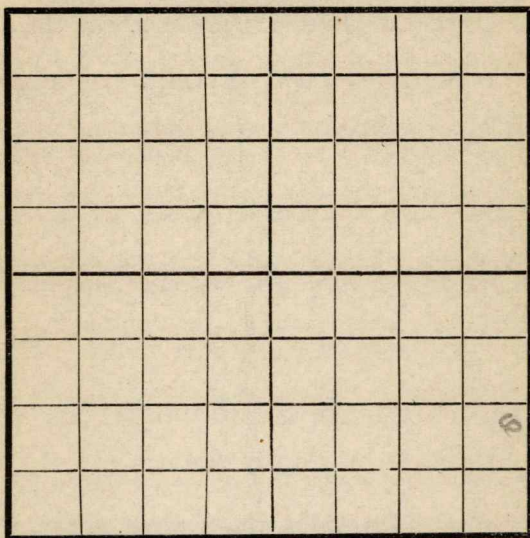

EAST

SOUTH

Location _____

Rig Up _____

Drilling and remarks

[Handwritten signature]

RECORD

Cased _____ in _____ Ft.

Sand _____

Gas _____

Oil _____

Total Depth _____

PRODUCTION

1st 24 hrs. Nat. _____

1st 24 hrs. after shot _____

Gas _____ Cu. Ft.

Dry Hole _____


Abandoned _____

Date

9/22, 1917 7 Condy Scout

Map No. _____ Sec. 32 Twp. 25 R. 7
Well No. 1 Reese Farm _____
Diamond oil Company

NORTH

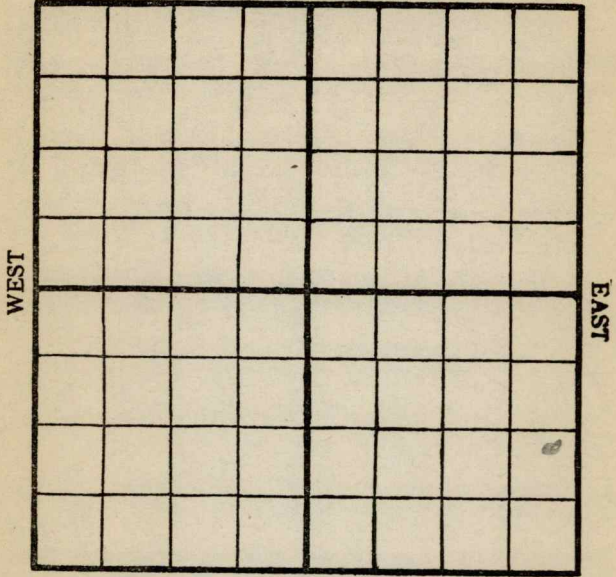

SOUTH


Location _____	RECORD
Rig Up _____	Cased _____ in. _____ Ft.
Drilling and remarks	Sand _____
<u>Spudded</u>	Gas _____
<u>in</u>	Oil _____
	Total Depth _____
	PRODUCTION
	1st 24 hrs. Nat. _____
	1st 24 hrs. after shot _____
	Gas _____ Cu. Ft.
	Dry Hole _____
	Abandoned _____

Date 10/2, 1917 Carless Scout

Map No. _____ Sec. 32 Twp. 25 R. 7Well No. 1 Reese Farm __________Diamond Company

NORTH

WEST

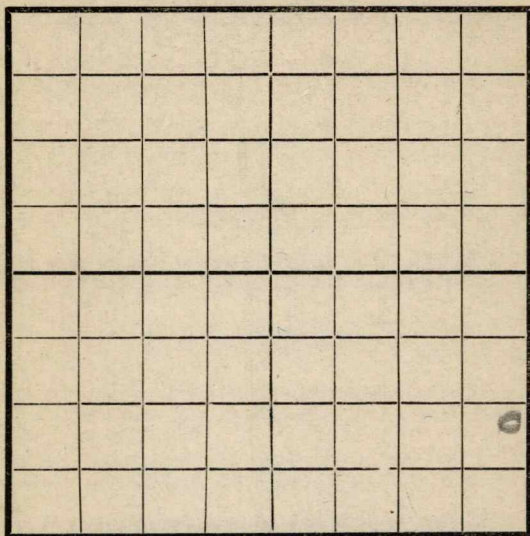

EAST

SOUTH

Location _____

Rig Up _____

Drilling and remarks

400

RECORD

Cased _____ in _____ Ft.

Sand _____

Gas _____

Oil _____

Total Depth _____

PRODUCTION

1st 24 hrs. Nat. _____

1st 24 hrs. after shot _____

Gas _____ Cu. Ft.

Dry Hole _____


Abandoned _____

Date

10/9, 1917 Carney Scout

Map No. _____ Sec. 32 Twp. 25 R. 7
Well No. 1 Reese Farm _____
Diamond Oil Company

NORTH

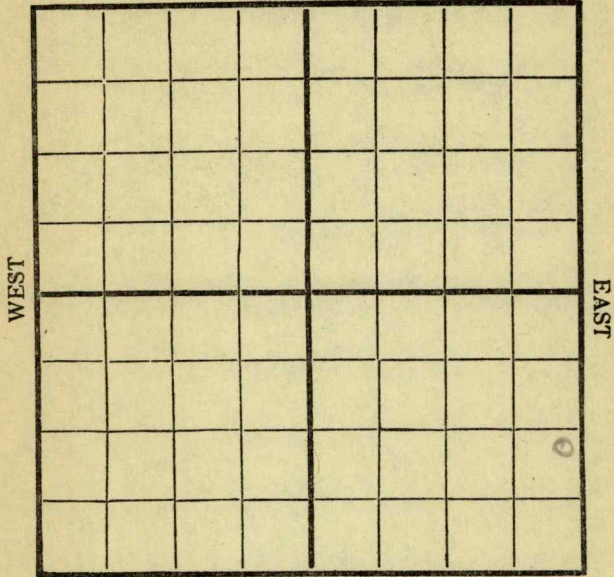

SOUTH

Location _____
Rig Up _____
Drilling and remarks

525

RECORD

Cased _____ in. _____ Ft.
Sand _____
Gas _____
Oil _____
Total Depth _____

PRODUCTION

1st 24 hrs. Nat. _____
1st 24 hrs. after shot _____
Gas _____ Cu. Ft.
Dry Hole _____
Abandoned _____


Date

10/17, 1917, Cardiff Scout

Map No. _____ Sec. 32 Twp. 25 R. 7Well No. 1 Reese Farm
Diamond Company

NORTH

WEST

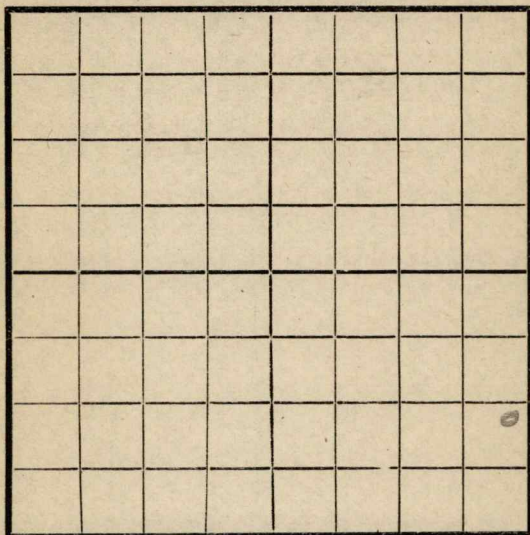

EAST

SOUTH

Location _____

Rig Up _____

Drilling and remarks

525

RECORD

Cased _____ in. _____ Ft.

Sand _____

Gas _____

Oil _____

Total Depth _____

PRODUCTION

1st 24 hrs. Nat. _____

1st 24 hrs. after shot _____

Gas _____ Cu. Ft.

Dry Hole _____

Abandoned _____


Date

10/24, 1917 C. Carey Scout

Map No. _____ Sec. 32 Twp. 25 R. 7Well No. 1 Reece Farm
Diamond Oil Company

NORTH

WEST

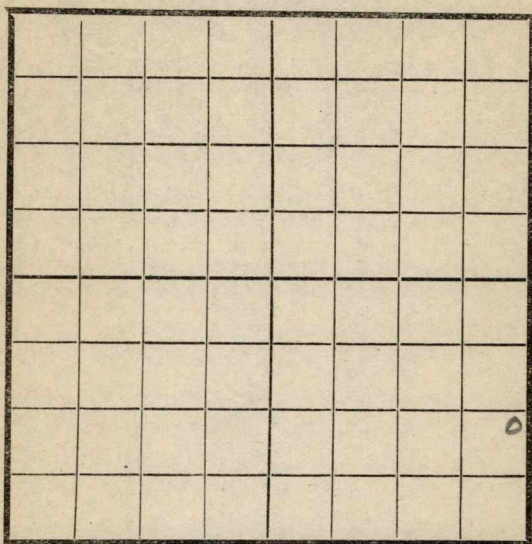

EAST

SOUTH

Location _____

Rig Up _____

Drilling and remarks

Fishing 740'

RECORD

Cased _____ in. _____ Ft.

Sand _____

Gas _____

Oil _____

Total Depth _____

PRODUCTION

1st 24 hrs. Nat. _____

1st 24 hrs. after shot _____

Gas _____ Cu. Ft.

Dry Hole _____

Abandoned _____

Date


10/31, 1917Pyle

Scout

Map No. _____ Sec. 32 Twp. 25 R. 7
 Well No. 1 Reece Farm
Diamond Oil Company

NORTH

WEST

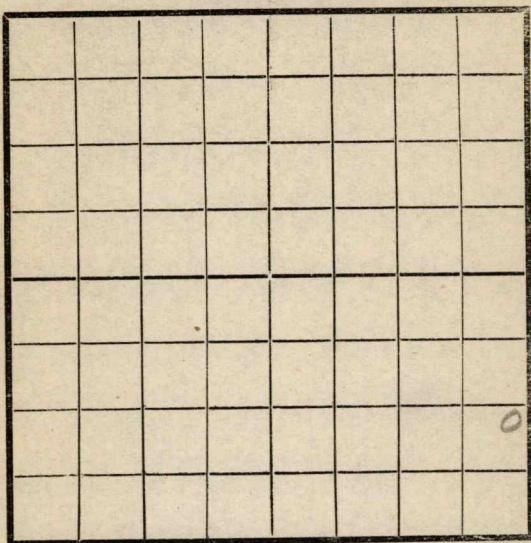

EAST

SOUTH

Location _____

Rig Up _____

Drilling and remarks

840'

RECORD

Cased _____ in. _____ Ft.

Sand _____

Gas _____

Oil _____

Total Depth _____

PRODUCTION

1st 24 hrs. Nat. _____

1st 24 hrs. after shot _____

Gas _____ Cu. Ft.

Dry Hole _____

Abandoned _____

Date

11/7, 1917 P. y. C. Scout

Map No. _____ Sec. 32 Twp. 25 R. 7


Well No. 1 Reece Farm

Diamond Company

NORTH

WEST

EAST

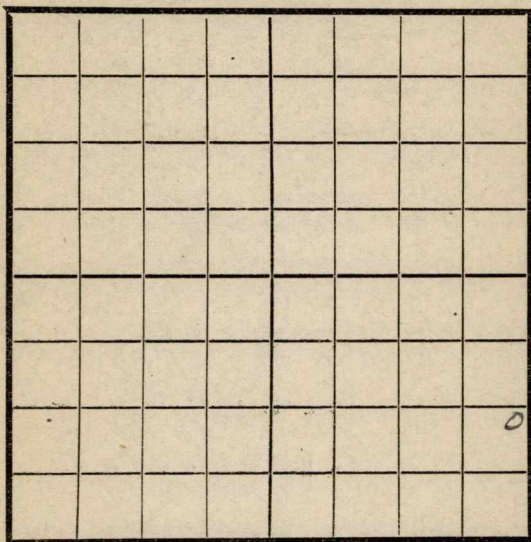

SOUTH

Location _____

Rig Up _____

Drilling and remarks

1110'

RECORD

Cased _____ in. _____ Ft.

Sand _____

Gas _____

Oil _____

Total Depth _____

PRODUCTION

1st 24 hrs. Nat. _____

1st 24 hrs. after shot _____

Gas _____ Cu. Ft.

Dry Hole _____

Abandoned _____

Date


11/14, 1917 Pyle Scout

Map No. _____ Sec. 32 Twp. 25 R. 7
 Well No. 1 Reece Farm
Diamond Company

NORTH

WEST

EAST

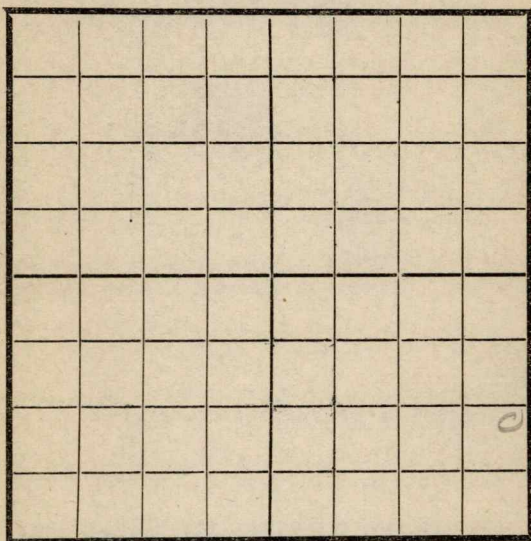

SOUTH

Location _____
 Rig Up _____
 Drilling and remarks

S. D. 1
1200'

RECORD

Cased _____ in. _____ Ft.
 Sand _____
 Gas _____
 Oil _____
 Total Depth _____

PRODUCTION

1st 24 hrs. Nat. _____
 1st 24 hrs. after shot _____
 Gas _____ Cu. Ft.
 Dry Hole _____
 Abandoned _____


Date

11/21, 1917 Dyke Scout

Map No. _____ Sec. 32 Twp. 25 R. 7
 Well No. 1 Peece Farm _____
Diamond Company _____

NORTH

WEST

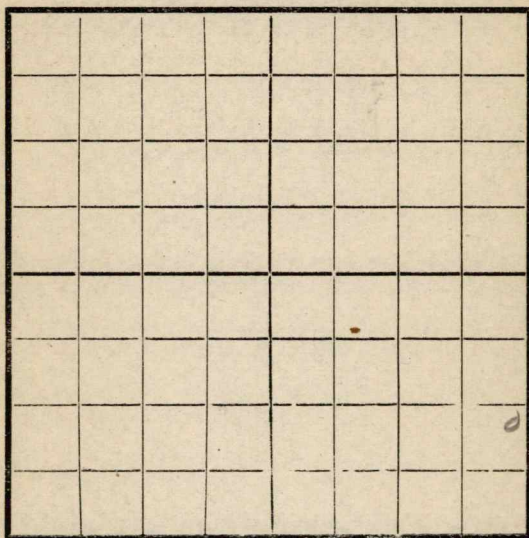

EAST

SOUTH

Location _____

Rig Up _____

Drilling and remarks

RECORD

Cased _____ in _____ Ft.

Sand _____

Gas _____

Oil _____

Total Depth _____

PRODUCTION

1st 24 hrs. Nat. _____

1st 24 hrs. after shot _____

Gas _____ Cu. Ft.

Dry Hole _____

Abandoned _____


Date

11/28, 1917 Peyce Scout

Map No. _____ Sec. 32 Twp 25 R. 7Well No. 1 Recess Farm
Diamond Oil Company

NORTH

WEST

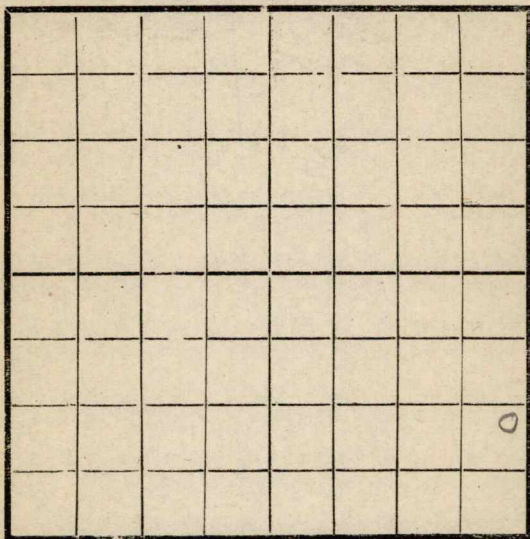

EAST

SOUTH

Location _____

Rig Up _____

Drilling and remarks

D. H.
1110'

RECORD

Cased _____ in. _____ Ft.

Sand _____

Gas _____

Oil _____

Total Depth _____

PRODUCTION

1st 24 hrs. Nat. _____

1st 24 hrs. after shot _____

Gas _____ Cu. Ft.

Dry Hole _____

Abandoned _____

Date

12/5, 191*7* *Pyle* Scout

Map No. _____ Sec. 32 Twp. 25 R. 7Well No. 1 Reese Farm _____Diamond Company _____

NORTH

WEST

EAST

SOUTH

Location _____

Rig Up _____

Drilling and remarks

RECORD

Cased _____ in. _____ Ft.

Sand _____

Gas _____

Oil _____

Total Depth _____

PRODUCTION

1st 24 hrs. Nat. _____

1st 24 hrs. after shot _____

Gas _____ Cu. Ft.


Dry Hole _____

Abandoned _____

Date

1/10 191 8 Pyle Scout

Map No. _____ Sec. 32 Twp. 25 R. 7
Well No. 1 Russell Farm
Diamond Oil Company
Date Started _____ Ft. from N _____ S _____ E _____ W _____ line
NORTH

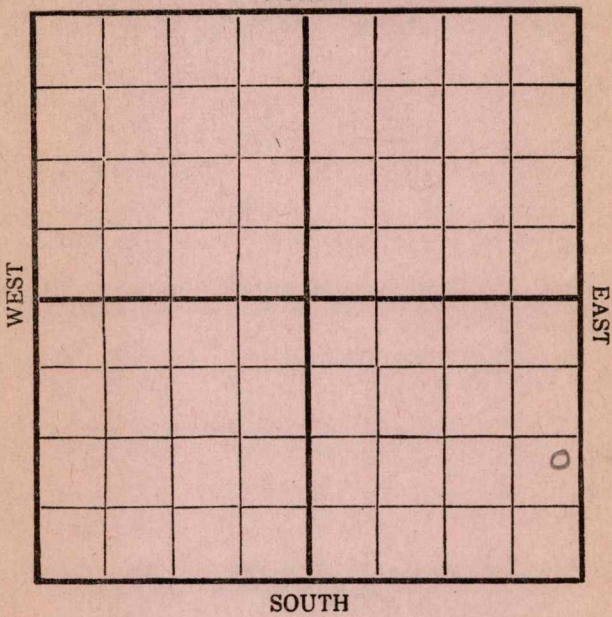

Cased _____ In. _____ Ft.	Production Remarks
Sand _____	
Pay { Gas _____ Oil _____	
Total Depth _____	

Condition of Well on this date 4/6/18


Q LD
@ 1110'
Oyle

Scout

Map No. _____ Sec. 32 Twp. 25 R. 7
 Well No. 1. Reece Farm _____
Diamond Company _____

NORTH

WEST

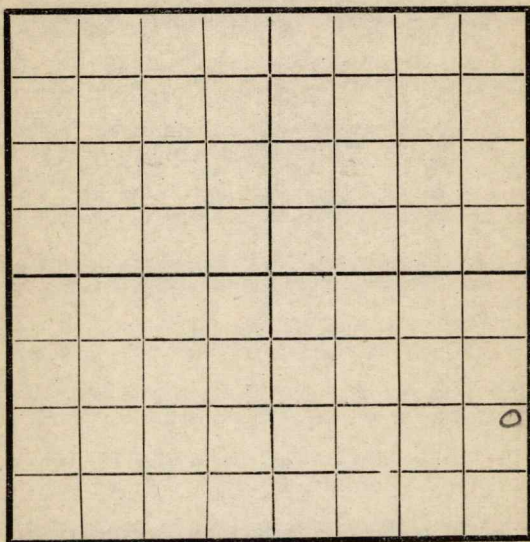

EAST

SOUTH

Location _____

Rig Up _____

Drilling and remarks

D. H.
@
1110

RECORD

Cased _____ in. _____ Ft.

Sand _____

Gas _____

Oil _____

Total Depth _____

PRODUCTION

1st 24 hrs. Nat. _____

1st 24 hrs. after shot _____

Gas _____ Cu. Ft.

Dry Hole _____

Abandoned _____


Date

2/12, 1918 *Pyle* Scout _____

Map No. _____ Sec. 32 Twp. 25 R. 7
 Well No. Reed Farm _____
Diamond Company _____

NORTH

WEST

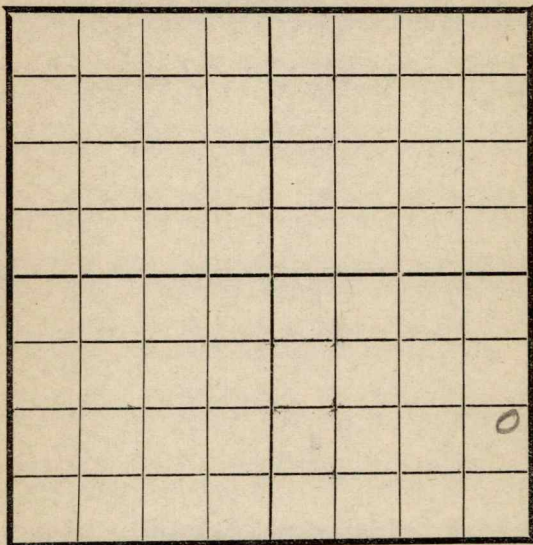

EAST

SOUTH

Location _____
 Rig Up _____
 Drilling and remarks

RECORD

Cased _____ in. _____ Ft.
 Sand _____
 Gas _____
 Oil _____
 Total Depth _____

PRODUCTION

1st 24 hrs. Nat. _____
 1st 24 hrs. after shot _____
 Gas _____ Cu. Ft.
 Dry Hole _____
 Abandoned _____


Date

2/18, 1917 Oyler Scout

Map No. _____ Sec. 32 Twp. 25 R. 7Well No. 1 Reece Farm _____
Hammond Company _____

NORTH

WEST

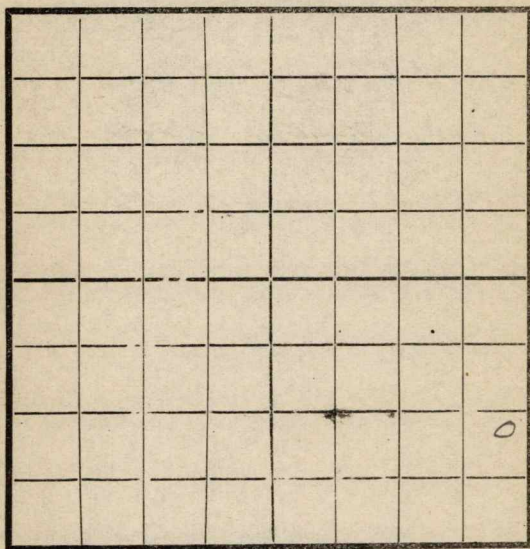

EAST

SOUTH

Location _____

Rig Up _____

Drilling and remarks

D. D. C.
1110'

RECORD

Cased _____ in. _____ Ft.

Sand _____

Gas _____

Oil _____

Total Depth _____

PRODUCTION

1st 24 hrs. Nat. _____

1st 24 hrs. after shot _____

Gas _____ Cu. Ft.

Dry Hole _____

Abandoned _____


Date

2/27, 191*8* *J. L. Pyle* Scout _____

Map No. _____ Sec. 32 Twp. 25 R. 7
 Well No. 1 Reel Farm _____
Diamond Oil Company

NORTH

WEST

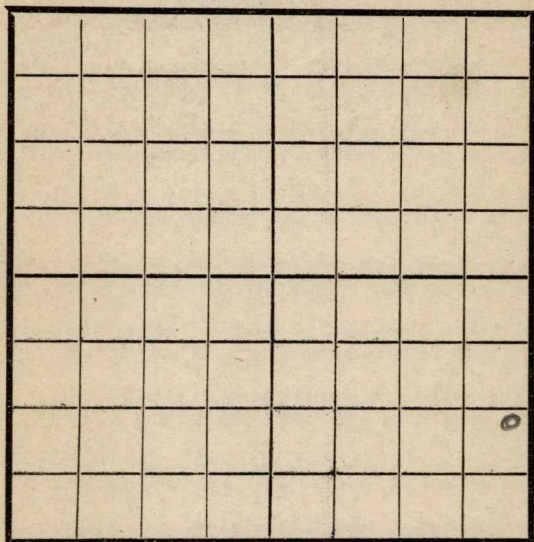

EAST

SOUTH

Location _____
 Rig Up _____
 Drilling and remarks _____

D. O.
1110'

RECORD

Cased _____ in. _____ Ft.
 Sand _____
 Gas _____
 Oil _____
 Total Depth _____

PRODUCTION

1st 24 hrs. Nat. _____
 1st 24 hrs. after shot _____
 Gas _____ Cu. Ft.
 Dry Hole _____
 Abandoned _____

Date 3/5, 1918 C. G. C. Scout

Map No. _____ Sec. 32 Twp. 25 R. 7
 Well No. 1 Reece Farm _____
Diamond oil Company

NORTH

WEST

EAST

SOUTH

Location _____
 Rig Up _____
 Drilling and remarks

D. D.
@
1110'

RECORD

Cased _____ in. _____ Ft.
 Sand _____
 Gas _____
 Oil _____
 Total Depth _____

PRODUCTION

1st 24 hrs. Nat. _____
 1st 24 hrs. after shot _____
 Gas _____ Cu. Ft.
 Dry Hole _____
 Abandoned _____


Date

3/12, 1918 Cyr Scout

Map No. _____ Sec. 32 Twp. 25 R. 7Well No. 1 Ruc Farm _____
Diamond Oil Company

NORTH

WEST

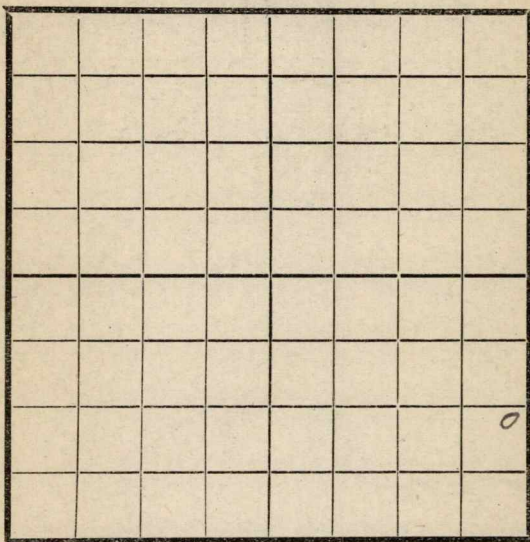

EAST

SOUTH

RECORD

Location _____

Cased _____ in. _____ Ft.

Rig Up _____

Sand _____

Drilling and remarks

Gas _____

Oil _____

Total Depth _____

PRODUCTION

1st 24 hrs. Nat. _____

1st 24 hrs. after shot _____

Gas _____ Cu. Ft.

Dry Hole _____

Abandoned _____

Date


4/3, 1918Py h

Scout

Map No. _____ Sec. 32 Twp. 25 R. 7
 Well No. 1 Reece Farm _____
Diamond Oil Company _____

NORTH

WEST

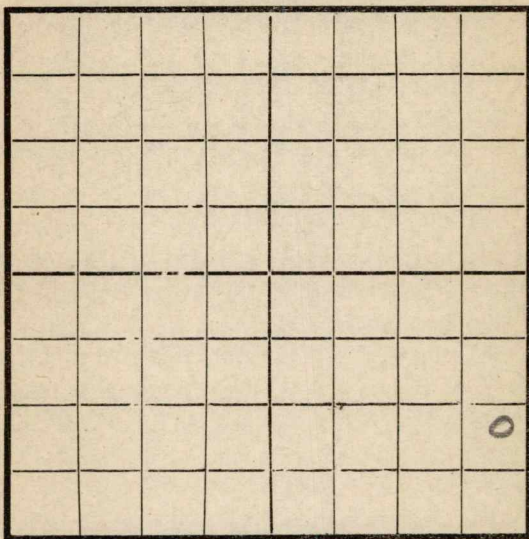

EAST

SOUTH

Location _____
 Rig Up _____
 Drilling and remarks _____

RECORD

Cased _____ in. _____ Ft.
 Sand _____
 Gas _____
 Oil _____
 Total Depth _____

PRODUCTION

1st 24 hrs. Nat. _____
 1st 24 hrs. after shot _____
 Gas _____ Cu. Ft.
 Dry Hole _____
 Abandoned _____


Date

4/5, 1918 Cyle Scout
10

Map No. _____ Sec. 32 Twp. 25 R. 7
 Well No. 1 Reece Farm _____
Diamond Oil Company _____

NORTH

WEST

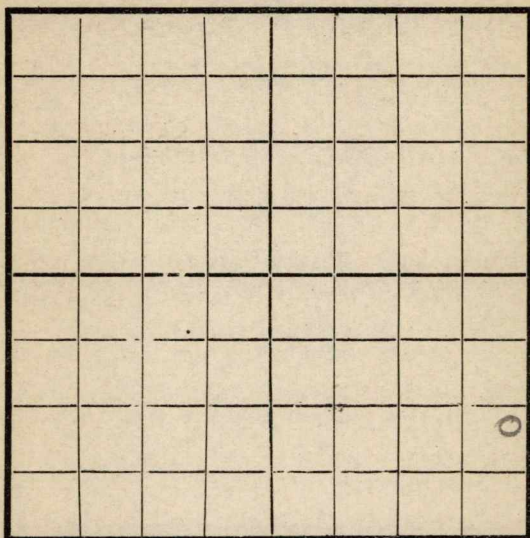

EAST

SOUTH

Location _____

Rig Up _____

Drilling and remarks

RECORD

Cased _____ in. _____ Ft.

Sand _____

Gas _____

Oil _____

Total Depth _____

PRODUCTION

1st 24 hrs. Nat. _____

1st 24 hrs. after shot _____

Gas _____ Cu. Ft.

Dry Hole _____

Abandoned _____


Date

4/8 1916 Scout
16

Map No. _____ Sec. 32 Twp. 25 R. 7
 Well No. 1 Reece _____ Farm _____
Diamond Oil _____ Company _____

NORTH

WEST

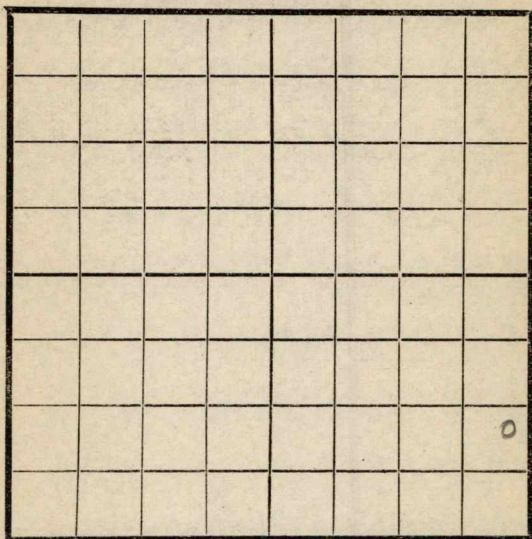

EAST

SOUTH

Location _____

Rig Up _____

Drilling and remarks

1850

RECORD

Cased _____ in _____ Ft

Sand _____

Gas _____

Oil _____

Total Depth _____

PRODUCTION

1st 24 hrs. Nat. _____

1st 24 hrs. after shot _____

Gas _____ Cu. Ft

Dry Hole _____

Abandoned _____

Date


4/8, 1918 Oryle Scout
25

Map No. _____ Sec. 32 Twp. 25 R. 7

Well No. 1 Recce Farm _____
Diamond Oil Company

NORTH

WEST

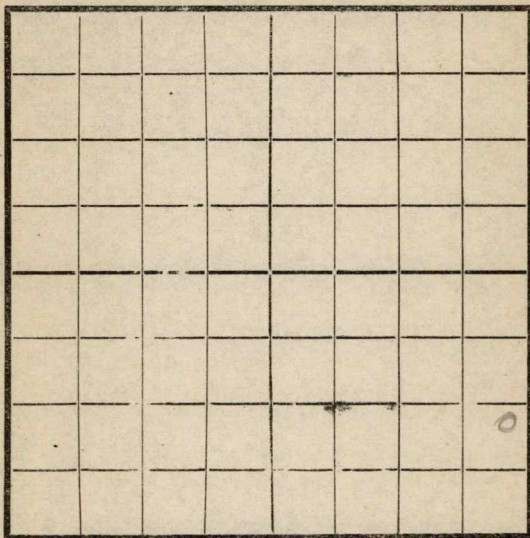

EAST

SOUTH

Location _____

Rig Up _____

Drilling and remarks

2030'

RECORD

Cased _____ in. _____ Ft.

Sand _____

Gas _____

Oil _____

Total Depth _____

PRODUCTION

1st 24 hrs. Nat. _____

1st 24 hrs. after shot _____

Gas _____ Cu. Ft.

Dry Hole _____

Abandoned _____

Date


5/2, 1918 C. J. C. Scout

Map No. _____ Sec. 32 Twp 25 R. 7

Well No. 1 Reece Farm
Diamond Oil Company

NORTH

WEST

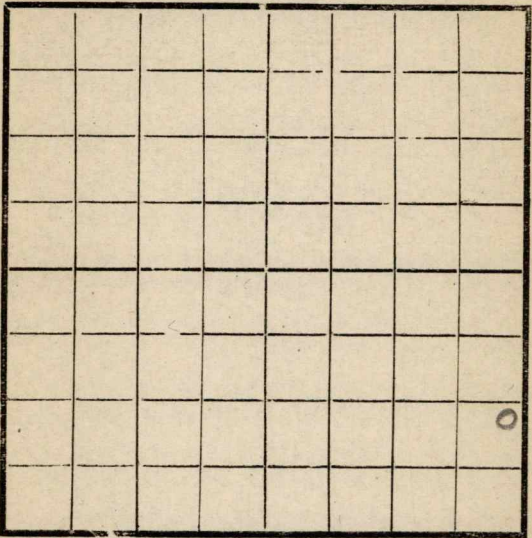

EAST

SOUTH

Location _____
 Rig Up _____
 Drilling and remarks _____

D. D. C.
2030'

RECORD

Cased _____ in. _____ Ft.
 Sand _____
 Gas _____
 Oil _____
 Total Depth _____

PRODUCTION

1st 24 hrs. Nat. _____
 1st 24 hrs. after shot _____
 Gas _____ Cu. Ft.
 Dry Hole _____
 Abandoned _____


Date

5/8, 1918 C. J. K. Scout
7

Map No. _____ Sec. 32 Twp. 25 R. 7
 Well No. 1 Reece Farm _____
Diamond Oil Company

NORTH

WEST

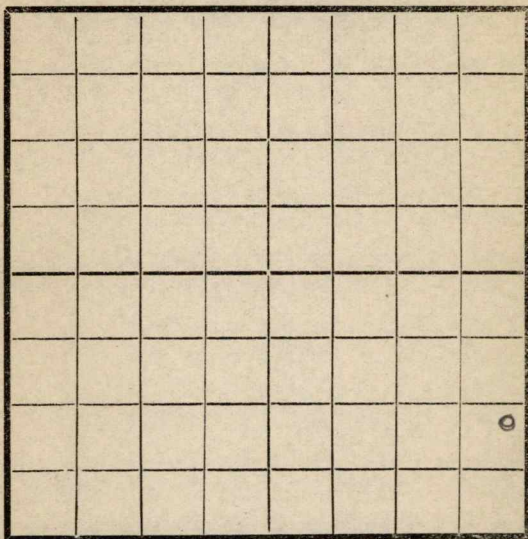

EAST

SOUTH

Location _____

Rig Up _____

Drilling and remarks

RECORD

Cased _____ in. _____ Ft.

Sand _____

Gas _____

Oil _____

Total Depth _____

PRODUCTION

1st 24 hrs. Nat. _____

1st 24 hrs. after shot _____

Gas _____ Cu. Ft.

Dry Hole _____

Abandoned _____


Date

5/, 1918 Gyle Scout
16

Map No. _____ Sec. 37 Twp. 25 R. 7
 Well No. 1 Reece Farm
Diamond Oil Company

NORTH

WEST

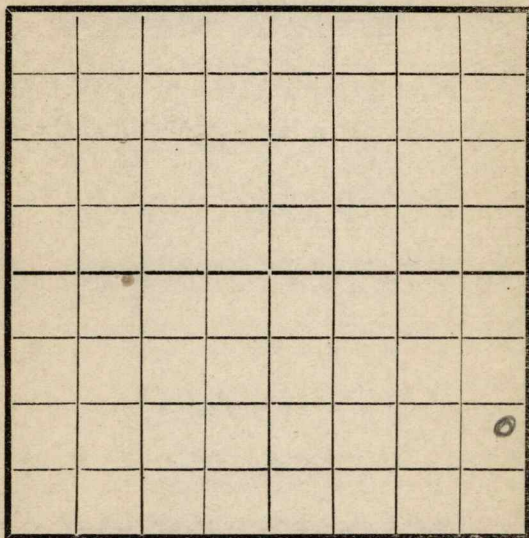

EAST

SOUTH

Location _____
 Rig Up _____
 Drilling and remarks

RECORD

Cased _____ in. _____ Ft.
 Sand _____
 Gas _____
 Oil _____
 Total Depth _____

PRODUCTION

1st 24 hrs. Nat. _____
 1st 24 hrs. after shot _____
 Gas _____ Cu. Ft.
 Dry Hole _____
 Abandoned _____

Date

5/8, 1918 Oyle Scout
24

Map No. _____ Sec. 32 Twp. 25 R. 7
Well No. 1 Piece
Diamond Oil Company
Contractor _____

NORTH

WEST

EAST

SOUTH

Location _____

Rig up

Drilling and Remarks:

2750'

RECORD

Cased-----in., -----ft.

Sand_____

Gas

Oil _____

Total Depth.....

PRODUCTION

1st 24 hrs. Nat. -----

1st 24 hrs. after shot.....

Gas.....Cu. Ft.

Dry Hole.....

Abandoned.....

Date _____

5/27 1918 Oyle Scout

Map No. _____ Sec. 32 Twp. 25 R. 7Well No. 1 _____Diamond Oil Company

Contractor _____

NORTH

WEST

EAST

SOUTH

Location _____

Rig up _____

Drilling and Remarks:

2840S.O.

RECORD

Cased _____ in., _____ ft.

Sand _____

Gas _____

Oil _____

Total Depth _____

PRODUCTION

1st 24 hrs. Nat. _____

1st 24 hrs. after shot _____

Gas _____ Cu. Ft.

Dry Hole _____

Abandoned _____

Date


4/51918Scout C. G. G.

Map No. _____ Sec. 32 Twp. 25 R. 7
 Well No. 1 Reece
Diamond Company
 Contractor

NORTH

WEST

EAST

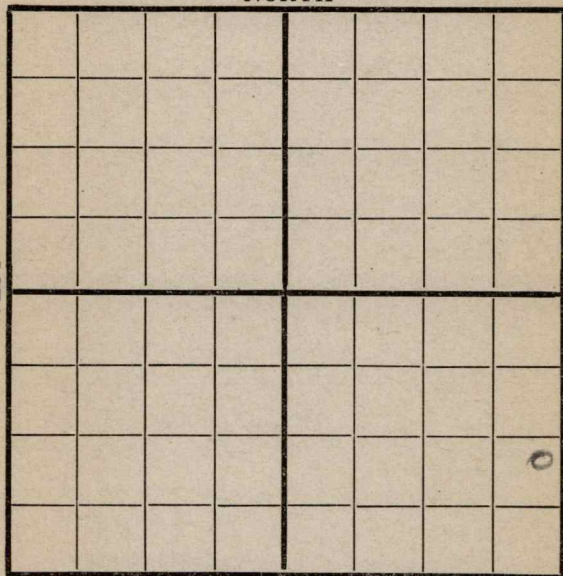

SOUTH

Location _____

Rig up _____

Drilling and Remarks:

2900'

RECORD

Cased _____ in., _____ ft.

Sand _____

Gas _____

Oil _____

Total Depth _____

PRODUCTION

1st 24 hrs. Nat. _____

1st 24 hrs. after shot _____

Gas _____ Cu. Ft.

Dry Hole _____

Abandoned _____

Date

6/14 1918 Cyle Scout

Map No. _____ Sec. 32 Twp. 25 R. 7
 Well No. 1 Reese
diamond Company _____
 Contractor _____

NORTH							
WEST							
SOUTH							

Location _____ Rig up _____ Drilling and Remarks: <u>D. D @</u> <u>2900'</u>	RECORD Cased _____ in., _____ ft. Sand _____ Gas _____ Oil _____ Total Depth _____ PRODUCTION 1st 24 hrs. Nat. _____ 1st 24 hrs. after shot _____ Gas _____ Cu. Ft. Dry Hole _____ Abandoned _____
--	---

Date 6/18 1918 Oyle Scout

Map No. _____ Sec. 32 Twp. 25 R. 7Well No. 1 ReeceDiamond Oil Company

Contractor _____

NORTH

WEST

EAST

SOUTH

Location _____

Rig up _____

Drilling and Remarks:

D. D. @
2930'
to deep -

RECORD

Cased _____ in., _____ ft.

Sand _____

Gas _____

Oil _____

Total Depth _____

PRODUCTION

1st 24 hrs. Nat. _____

1st 24 hrs. after shot _____

Gas _____ Cu. Ft.

Dry Hole _____


Abandoned _____

Date

1918

Scout

Map No. _____ Sec. 32 Twp. 25 R. 7
Well No. 1 Beech
Diamond Oil Company
Contractor _____

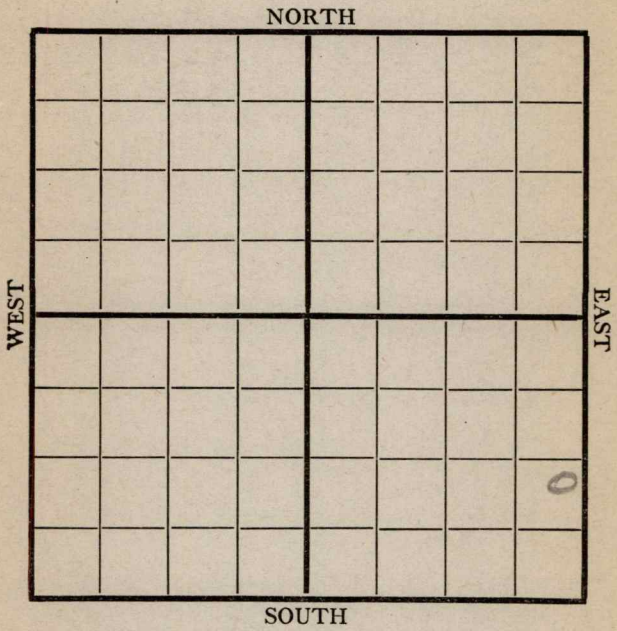


	RECORD
Location _____	Cased _____ in., _____ ft.
Rig up _____	Sand _____
Drilling and Remarks: <u>D. 10 @</u> <u>2930'</u>	Gas _____
	Oil _____
	Total Depth _____
	PRODUCTION
	1st 24 hrs. Nat. _____
	1st 24 hrs. after shot _____
	Gas _____ Cu. Ft.
	Dry Hole _____
	Abandoned _____

Date 7/2 1918 Clyde Scout

Map No. _____ Sec. 32 Twp. 25 R. 7Well No. 1 Reece Farm
Diamond Oil Company

NORTH

WEST

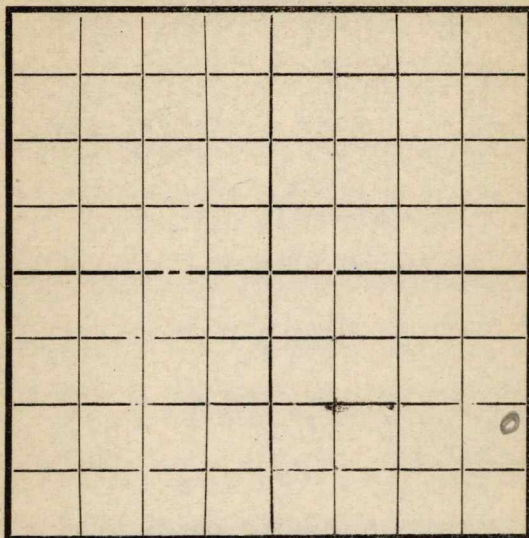

EAST

SOUTH

Location _____

Rig Up _____

Drilling and remarks

D. 10. @
1930'

RECORD

Cased _____ in. _____ Ft.

Sand _____

Gas _____

Oil _____

Total Depth _____

PRODUCTION

1st 24 hrs. Nat. _____

1st 24 hrs. after shot _____

Gas _____ Cu. Ft.

Dry Hole _____

Abandoned _____

Date

7/10, 1918 Oyle Scout

Map No. 115 Sec. 32 Twp. 25 R. 7Well No. 1 ReeceDiamond Oil Company

Contractor

NORTH

WEST

EAST



SOUTH

Location _____

Rig up _____

Drilling and Remarks:

RECORD

Cased _____ in., _____ ft.

Sand _____

Gas _____

Oil _____

Total Depth _____

PRODUCTION

1st 24 hrs. Nat. _____

1st 24 hrs. after shot _____

Gas _____ Cu. Ft.

Dry Hole 2930'

Abandoned _____

Date

191

7/8 8 Oyle Scout