



Greenwood

Map No. **KANSAS** Sec. 1 Twp. 25 R. 8

Well No. 1-Claycomb Farm


Nelson-Kimmel et al Company

250 Ft. from N. Line

..... Ft. from S. Line

250 Ft. from E. Line

..... Ft. from W. Line

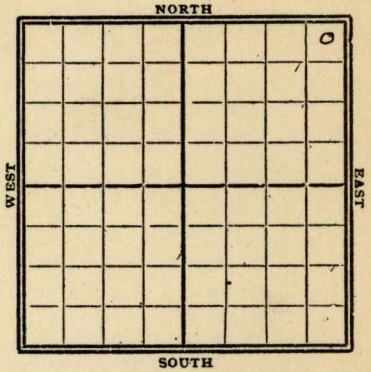

1928

Date	REPORT
------	--------

10/31	Rdg.
11/7	Rig.
11/14	Rigging up
11/21	Spudding
11/28	Drlg 400'
12/5	" 1040'
12/12	" 1275'
12/19	S.D. 1520'
12/26	.....
1929	
1/2	drlg 1600'
1/9	rng 6"-2180'
1/16	.....
1/23	sand 2165-80' dry
	Top line 2445'
	T.D. 2475'
	dry & Abandoned

*Sherwood*

**K15** KANSAS MAP No. \_\_\_\_\_ SEC. 1 TWP. 25 R. 8

WELL No. 1 *Clay Comb*

*Nelson-Kimmel et al* COMPANY

CONTRACTOR

### FIRST REPORTS

250 FT. FROM N. LINE

FT. FROM S. LINE

250 FT. FROM E. LINE

FT. FROM W. LINE

### SECTION PLAT

			0

LOCATION *P.O.G.*

RIG UP *P.O.G.*

DRILLING AND REMARKS:

### RECORD

CASED \_\_\_\_\_ IN. \_\_\_\_\_ FT.

SAND \_\_\_\_\_

GAS \_\_\_\_\_

OIL \_\_\_\_\_

TOTAL DEPTH \_\_\_\_\_

### PRODUCTION

1ST 24 HRS. NAT. \_\_\_\_\_

1ST 24 HRS. AFTER SHOT \_\_\_\_\_

GAS \_\_\_\_\_ CU. FT.

DRY HOLE \_\_\_\_\_

ABANDONED \_\_\_\_\_

DATE  
**OCT 31 1928**

**CHAS. L. SHERWOOD**  
SCOUT

*Sherwood*

Map No. **KANSAS** Sec. *1* Twp. *25* R. *8*

Well No. *K15* *1* *Claycomb*

*Nelson-Kimmel et al* Company

Contractor

**COMPLETE**

SECTION PLAT

*750* Ft. from N. Line

Ft. from S. Line

*750* Ft. from E. Line

Ft. from W. Line

			o

**ABANDONED**

Location.....

Rig up.....

Drilling and Remarks:

*Sand 2165-2180' Dry*  
*Top line 2445'*

RECORD

Cased..... in., ..... ft.

Sand.....

Gas.....

Oil.....

Total Depth *2475*

PRODUCTION

1st 24 hrs. Nat.....

1st 24 hrs. after shot.....

Gas..... Cu. Ft.

Dry Hole

Abandoned

Date

**JAN 23 1929**

**CHAS. L. SHERWOOD**

192..... Scout