




*Subgwick*

Map No. \_\_\_\_\_ Sec. *24* Twp. *25* R. *1E*

Well No. *1 - Samuels* Farm \_\_\_\_\_

*Ed Spencer* Company \_\_\_\_\_

NORTH

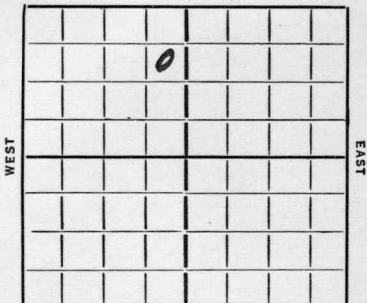

*990* Ft. from N. Line

\_\_\_\_\_ Ft. from S. Line

*330* Ft. from E. Line

\_\_\_\_\_ Ft. from W. Line

REPORT

Day

*1935*  
*12/4* *Cellar*  
*12/13* *12/19 - 12/26 - 1/2/36 - 1/10 -*  
*1/15* *Abandoned location*

**ABANDONED**

Map No. 13 Sec. 24 Twp. 25 R. 13

Well No. 1 - Samuels  
Ted Spencer Company

Contractor

FIRST REPORTS

SECTION PLAT

990 Ft. from N. Line

..... Ft. from S. Line

330 Ft. from E. Line

..... Ft. from W. Line

	0		

Location.....

Rig up.....

Drilling and Remarks:

cellar

RECORD

Cased..... in., ..... ft.

Sand.....

Gas.....

Oil.....

Total Depth.....

PRODUCTION

1st 24 hrs. Nat.....

1st 24 hrs. after shot.....

Gas..... Cu. Ft.

Dry Hole.....

Abandoned.....

Date

12-4-35 192.....

ORVAL MANSCHRECK

Scout

Map No. 13 Sec. 24 Twp. 25 R. 1E

Well No. 1-Samuels

Ted Spencer Company

Contractor

ABANDONED

SECTION PLAT

990 Ft. from N. Line

..... Ft. from S. Line

330 Ft. from E. Line

..... Ft. from W. Line


Location.....

Rig up.....

Drilling and Remarks:

*abd  
for*

RECORD

Cased..... in., ..... ft.

Sand.....

Gas.....

Oil.....

Total Depth.....

PRODUCTION

1st 24 hrs. Nat.....

1st 24 hrs. after shot.....

Gas..... Cu. Ft.

Dry Hole.....

Abandoned.....

Date

1-15-36 192.....