


Map No. 15 Sec. 1 Twp. 25 R. 8
 Well No. 1 Clay Comb Farm
Nathan et al Company

NORTH

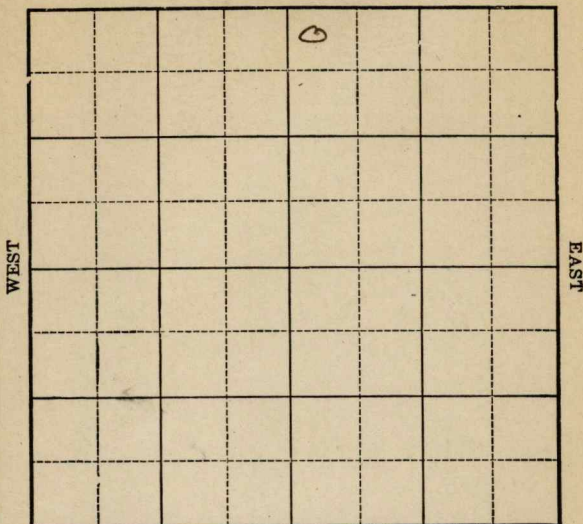

SOUTH

Location _____

Drilling Remarks _____

Rig Up _____

Drilling Remarks _____

Loc alid

RECORD

Cased _____ in. _____ ft.

Sand _____

Gas _____

Oil _____

Total Depth _____

PRODUCTION

1st 24 hrs. Nat. _____

1st 24 hrs. after shot _____


Gas _____ cu. ft.

Dry Hole _____

Abandoned _____

Map No. 15 ans. Sec. 1 Twp. 25 R. 8Well No. 1 Claycomb Farm
Nathan et al Company

NORTH

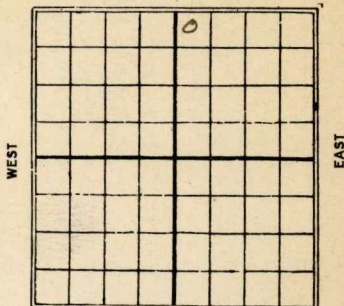300 Ft. from N. Line

_____ Ft. from S. Line

_____ Ft. from E. Line

300 Ft. from W. Line

SOUTH

1926

Date

REPORT

10/6 Location10/13 same10/27 same11/11 same11/17 _____11/23 _____12/8 _____12/15 _____12/22 _____12/30 _____1927 _____1/6 _____1/13 _____1/19 Abandoned Loc

15 **KANSAS** *Sheltonwood*
 Map No. _____ Sec. *1* Twp. *25* R. *8*

Well No. *1* *Clay Comb*
NATHAN et al _____ Company

 Contractor

SECTION PLAT

300 _____ Ft. from N. Line

_____ Ft. from S. Line

_____ Ft. from E. Line

300 _____ Ft. from W. Line

		<i>0</i>	

FIRST REPORTS

Location *✓* _____

Rig up _____

Drilling and Remarks:

RECORD

Cased _____ in., _____ ft.

Sand _____

Gas _____

Oil _____

Total Depth _____

PRODUCTION

1st 24 hrs. Nat. _____

1st 24 hrs. after shot _____

Gas _____ Cu. Ft.

Dry Hole _____

Abandoned _____

Date

OCT 6 1926

CHAS. L. SHERWOOD

192

Scout

Sherwood
 15-KANSAS
 Map No. _____ Sec. *1* Twp. *25* R. *8*
 Well No. *1 Claycomb*
Rathons I al _____ Company _____

Contractor _____

COMPLETED

SECTION PLAT

300 _____ Ft. from N. Line

_____ Ft. from S. Line

_____ Ft. from E. Line

300 _____ Ft. from W. Line

ABANDONED

		°	

Location _____

Rig up _____

Drilling and Remarks:

RECORD

Cased _____ in., _____ ft.

Sand _____

Gas _____

Oil _____

Total Depth _____

PRODUCTION

1st 24 hrs. Nat. _____

1st 24 hrs. after shot _____

Gas _____ Cu. Ft.

Dry Hole _____

Abandoned _____

Date

JAN 19 1927

192

CHAS. L. SHERWOOD

Scout