


Sedgwick

Map No. KANSAS Sec. 24 Twp. 25 R. 1^E

Well No. 1 *Samuels* Farm

Barnsdall Oil Company

NORTH

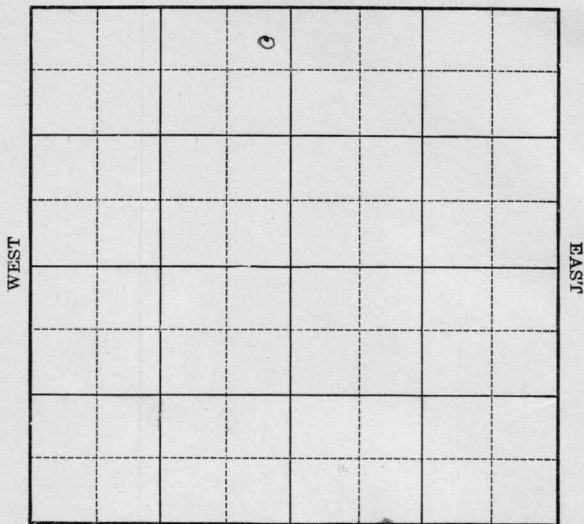

SOUTH

OWDD

Location _____

Drilling Remarks _____

Rig Up _____

Drilling Remarks _____

RECORD

Cased _____ in. _____ ft.

Sand _____

Gas _____

Oil _____

Total Depth _____

PRODUCTION

1st 24 hrs. Nat. _____

1st 24 hrs. after shot _____


Gas _____ cu. ft.

Dry Hole _____

Abandoned _____

Map No. KANSAS Sec. 24 Twp. 25 R. 1E
Well No. 1-Samuel Farm
Barnsdall Oil Company

NORTH

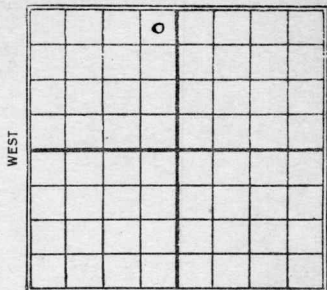

SOUTH

330 Ft. from N. Line

_____ Ft. from S. Line

330 Ft. from E. Line

_____ Ft. from W. Line

1928

Date	REPORT
9/12	Rodl.
9/19	Bldg. Rig
9/26	Rign up
10/3	Spud
10/10	Drlg 520'
10/17	" 620'
10/24	" 1100'
10/31	" 1328'
11/7	Swedging 12"-1375 T.D.
11/14	T.D. 1400 fsg csg.
11/19	10rlg 2800'
12/5	T.D. 1400' fsg. csg.
12/12	10rlg 1575'
12/19	" 2041'
12/26	" 2340'
1929	
1/2	" 2500'
1/9	" 2660 -2 B.W.
1/16	Base K.C. line 2715'
	drlg 2930'
	(over)

- 1/21- Top chat 3053'
 set 140' liner —
 1000' oil & 500' water
 Swabbed 107 bbls 11 hrs
 Bailing water — Kill
 U/R 8" and test
- 1/23- Pay 3053' - T.D. chat
 swabbed 113 bbls.
 oil & 30 bbl water
 in 12 hrs.
- 1/25- swab 132 bbls oil
 and 60 " water
 in 24 hrs.
- 1/28- 115 bbls oil } 17 hrs.
 45 " water } swab
- 1/29- 90 bbls oil } 16 hrs.
 40 " water }
- 2/1- swab 127 bbls 14 hrs.
 lots of water
- 2/4- 90 bbls oil - 30 bbl water
- 2/6- rmg tubing
- 2/13- No test
- 2/20
- 2/26- swabbed 125 bbl oil
 35 " water
- 3/5- 82 bbl oil - 35 bbl water
- 3/7- 105 " oil 45 " water
- 3/8- 80 " oil - 40 " water ^{PUMP}
- 3/11- 82 " oil - 35 " water
- 3/12- 108 " oil 35 " water
- 3/14- 142 " oil 55 " water
- 3/15- Top chat 3053'
 T.D. 3067'
 Pump 115 bbls oil
 35 " water
 Pump.


Map No. Kans. Sec. 24 Twp. 25 R. 1^E
 Well No. 1 - Samuels Farm
Barnsdall Oil Company

330 Ft. from N. Line

 Ft. from S. Line

370 Ft. from E. Line

 Ft. from W. Line

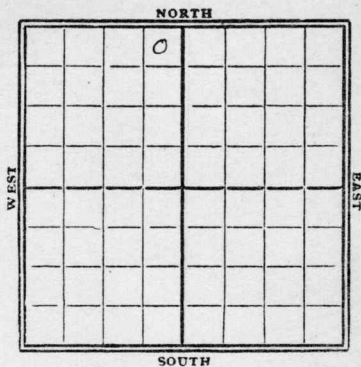

Date

REPORT

Production

3/16	50 bbls oil - 30 bbl water
3/18	97 " oil - 45 " water
3/19	60 " oil - 40 " water
3/21	80 " oil - 45 " water
3/22	92 " oil 45 " water
3/25	72 " oil 65 " water
3/26	20 " oil 10 " water
4/1	137 " oil 70 " water
4/19	70 " oil 70 " water
1929	OWDID old T.D. 3067
5/22	Ran up
5/29	T.D. 3067 - C.O.
6/5	W.R. 6" - 3145
6/12	only 3200'
6/19	" 3312
6/26	" 3372
7/2	3440
7/10	Wilcox 3460 - 80 HFW
	Top Oil line 3505
	only 3535'
7/17	" 3720'

7/24 - T.D. 3662' (SLM)

P.B. to Chat

7/31 - set 6" - 3060'

8/7 —

8/14 - S.D.

8/21 - Pumping water

8/28 —

9/4 —

9/11 - T.D. 3662'

Dry & Abandoned

K13

MAP NO. KANSAS SEC. 24 TWP. 25 R. 1E

WELL NO. 1 Samuels

Barnesclall Oil COMPANY

CONTRACTOR

SECTION PLAT

	0		
			1

330 FT. FROM N. LINE

FT. FROM S. LINE

330 FT. FROM E. LINE

FT. FROM W. LINE

FIRST REPORTS

LOCATION

RIG UP

DRILLING AND REMARKS:

ROY

RECORD

CASED IN. FT.

SAND

GAS

OIL

TOTAL DEPTH

PRODUCTION

1ST 24 HRS. NAT.

1ST 24 HRS. AFTER SHOT

GAS Cu. Ft.

DRY HOLE

ABANDONED

DATE

SEP 12 1928

S. J. LEWIS

192

SCOUT

Map No. 13 Sec. 24 Twp. 25 R. 1E

Well No. 1 Samuel

Barnes Oil Company

Contractor

SECTION PLAT


330 Ft. from N. Line

..... Ft. from S. Line

330 Ft. from E. Line

..... Ft. from W. Line

COMPLETED

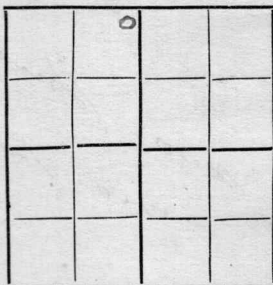

Location

Rig up

Drilling and Remarks:

Top Chat 3053

Total Depth 3067

Pump 115 ft. hole

35 ft. water

RECORD

Cased in., ft.

Sand

Gas

Oil

Total Depth 3067

PRODUCTION

1st 24 hrs. Nat.

1st 24 hrs. after shot

Gas Cu. Ft.

Dry Hole

Abandoned

Date

MAR 13 1929

192

S. J. LEWIS

Scout

Sealquatic
 Map No. KANSAS Sec. 24 Twp. 25 R. 1E

Well No. 1 Samuels

Barnesclaff Oil Company

Contractor

SECTION PLAT

	0		

320 Ft. from N. Line

..... Ft. from S. Line

330 Ft. from E. Line

..... Ft. from W. Line

OW II

Location.....

Rig up.....

Drilling and Remarks:

Rigging up

RECORD

Cased.....in.,ft.

Sand.....

Gas.....

Oil.....

Total Depth 2067

PRODUCTION

1st 24 hrs. Nat.....

1st 24 hrs. after shot.....

Gas.....Cu. Ft.

Dry Hole.....

Abandoned.....

Date

MAY 22 1929

192.....

S. J. LEWIS Scout

Map No. KANSAS Sec. 24 Twp. 25 R. 15

Well No. 1 Samuel

Barasclaw Oil Company

Contractor

SECTION PLAT

	0		

330 Ft. from N. Line

..... Ft. from S. Line

330 Ft. from E. Line

..... Ft. from W. Line

ABANDONED

Location.....

Rig up.....

Drilling and Remarks:

RECORD

Cased.....in.,ft.

Sand.....

Gas.....

Oil.....

Total Depth 3662

PRODUCTION

1st 24 hrs. Nat.....

1st 24 hrs. after shot.....

Gas.....Cu. Ft.

Dry Hole.....

Abandoned.....

Date

SEP 1 1 1929

192.....

S. J. LEWIS Scout