


Section 23 Township 26 Range 6E

Well No. #1 Allen

Company Palmer Oil

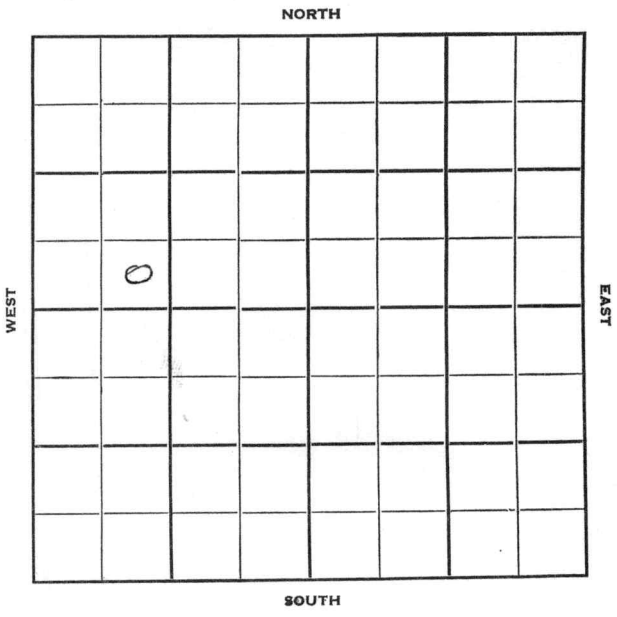

Butler

23

26 KANSAS 6 E

Sec. _____ Twp. _____ R. _____

1 Allan

Well No. _____ Farm _____

Palmer Oil

Company _____

Wickson

Wildcat

Contractor _____

_____ Ft. from N. Line

330


_____ Ft. from S. Line

_____ Ft. from E. Line

990

_____ Ft. from W. Line

SE SW NW

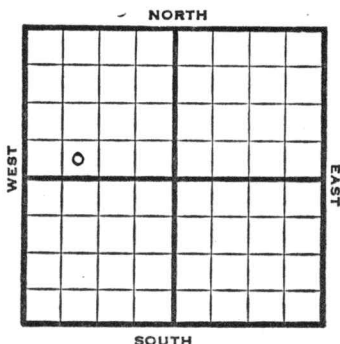

1951

Elev. 1416' REPORT

11/7

Location

12/19

Spud 11-10-51

D & A TD 3200' 13" @ 865'

Lans. 1810' 10" @ 1882'

B KC 1980' 8" @ 2440'

Miss 2779' 7" @ 2936'

Viola 3195' 5" @ 3150'

TD 3200' HFW

D & A


ABANDONED

County Butler State Kansas
 Sec. 23 (Blk. 26 (Sur. 6E Map No.
 Twp. Rge.)

Operator Palmer Oil

Well No. 1 Farm Allan

Elev. 1416 Location SE SW NW

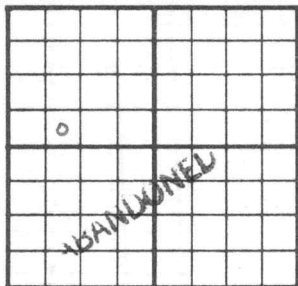

330 Ft. From S Line NW

990 Ft. From W Line Quarter

1st. Report

Completion DEC 19 1951

Remarks Wildcat

Wixson - Contr.

Spudding Date 11-10-51

Drlg. Data D & A TD 3200

13" @ 865 Lans. 1810 10" @ 1882

B KC 1980 8" @ 2440 Miss. 2779

7" @ 2936 Viola 3195 5" @ 3150

TD 3200 HFW

D & A

J. E. TYRA