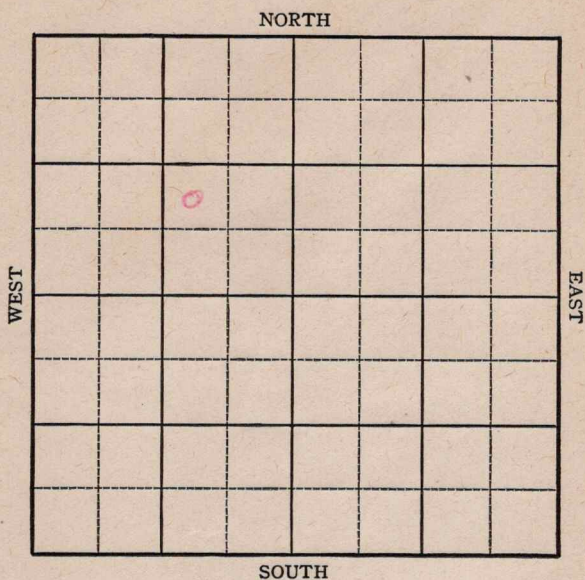


KANSAS Sedgwick

Section 1 Township 27 Range 1EWell No. 1 McLeanCompany Beech Aircraft

KANSAS Sedgwick

Sec. 1 Twp. 27 R. 1-E

Well No. #1 McL ean Farm


Beech Aircraft Company

 Ft. from N. Line

990 Ft. from S. Line

990 Ft. from E. Line

 Ft. from W. Line

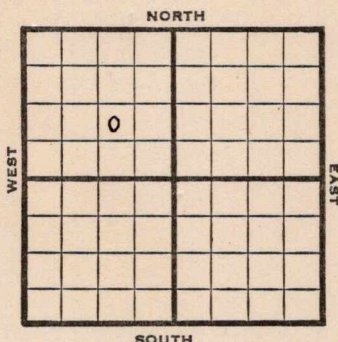

NW SE NW

1945 **Elev. 1353'** REPORT

9/5 9/12 9/19 9/26 10/3 10/10 10/17 10/24 10/31 11/7 11/14 11/21 11/28 12/5 12/12 12/20 12/29 1946 1/10	Location Machine " Drlg. 365 15" @ 115 885 Ream hole " " " 12" @ 995 Drlg. 1625 Drlg. 1975 10" @ 1825 2430 S.D. for 8" 8" @ 2430 Drlg. 2430 KC 2527 TD 2675 Run 7" 7" @ 2615 5" @ 2968 Brugess 2923-2979 TD 2979 30 shots 2975-2977 Pump 75 oil 5" @ 2975 WOC " " " TD 3002 HFW " " " " " "
--	---

OVER

753588

1946		
1/17	TD 3002'	HFW.
1/24	"	"
1/31	"	"
2/7	"	"

2/13	Miss. 3009
	TD 3025'

ABANDONED

KANSAS

Kansas Pool Name Derby GasMap No. 12 Sec. 1 Twp. 27 R. 1EWell No. 1 McLeanBeech Aircraft


Company

FIRST REPORT

Contractor

NW SE NW

SECTION PLAT

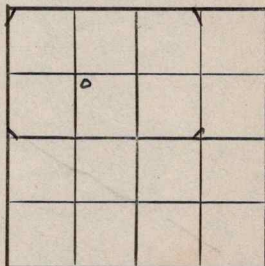 Ft. from N. Line990 Ft. from S. Line990 Ft. from E. Line Ft. from W. LineSedgwick CountyLocation XRig up

Drilling and Remarks:

RECORD

Cased in., ft.Sand Gas Oil Total Depth

PRODUCTION

1st 24 hrs. Nat. 1st 24 hrs. after shot Gas Cu. Ft.Dry Hole Abandoned

Date

SEP 5 1945S. J. LEWIS Scout

KANSAS Kansas Pool Name Derby GasMap No. 12 Sec. 1 Twp. 27 R. 1EWell No. 1 McLeanBeech Aircraft

Company

ABANDONED

Contractor

NW SE NW

E11303

SECTION PLAT

 Ft. from N. Line990 Ft. from S. Line990 Ft. from E. Line Ft. from W. Line

	0		

Sedgwick CountyLocation Rig up

Drilling and Remarks:

Wias 3009

RECORD

Cased in., ft.Sand Gas Oil Total Depth 3025

PRODUCTION

1st 24 hrs. Nat. 1st 24 hrs. after shot Gas Cu. Ft.Dry Hole Abandoned

Date

FEB 13 1946

19

S. J. LEWIS

Scout