


Section 30 Township 25 Range 1 E

Well No. #1 Drake


Company Petroleum Inc.



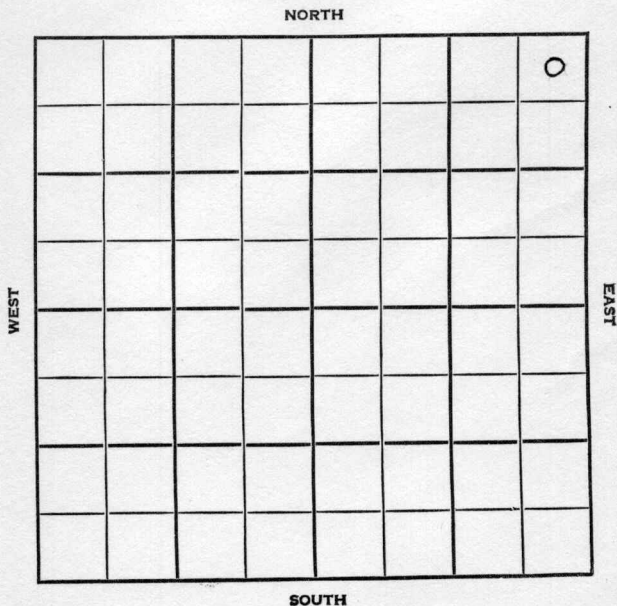

County Sedgwick Elev. \_\_\_\_\_ Co.  
 Sec. 30 Twp. 25 Rge. 1E  
 Company Petroleum Inc.  
 Farm Name Drake No. 1

TOPS	DEPTH	LOG	DATUM
Anh.			
TP.			
H.			
Tr.			
Dg.			
Bl.			
L.			
K.C.			
B.K.C.			
Ce.			
C.			
M.			
M.			
K.			
Mz.			
Mq.			
V.			
S.			
S.			
A.			
R.			
Pe.			
G.			
T.D.			

Loc. in Sec. \_\_\_\_\_  
NE NE NE  
 Geol. \_\_\_\_\_  
 Contr. \_\_\_\_\_  
 Pool \_\_\_\_\_  
Wildcat  
  
**FIRST REPORT**  
 OCT 5 '55

Date Comm. 10-1-55  
8" @ 145/125 drlg. 1668

Co.  
Lse.  
No.  
Sec.  
T.  
R.

County Sedgwick Elev. 1368  
 Sec. 30 Twp. 25 Rge. 1E  
 Company Petroleum Inc.  
 Farm Name Drake No. 1

TOPS	DEPTH	LOG	DATUM
Anh.			
Tp.			
H.			
Tr.			
Dg.			
Bl.	2256	2252	884
L.	2309	2316	948
K.C.	2559	2562	1194
B.K.C.	2758	2748	1380
Ce. <u>sh</u>	2966		
C.			
M. <u>arm</u>	2796		1428
M.			
K. <u>Burg</u>	3027	3044	1676
Mz.			
Mq. <u>Miss</u>	3051	3074	1706
V.			
S. <u>Kk</u>	3364	3396	1028
S. <u>Hunten</u>		3450	2082
A. <u>Viola</u>	3488	3491	2123
R. <u>simp</u>	3514	3514	2146
Pe. <u>arlt</u>	3597	3597	2229
G.			
T.D.	3622	3623	

Loc. in Sec. NE NE NE  
 Geol. \_\_\_\_\_  
 Contr. \_\_\_\_\_  
 Pool Wildcat  

		0

ABANDONED

Date Comm. 10-1-55 OCT 19 1955  
8" @ 145/125 DST 3450-55 open 1 hr.  
Rec. 1900' sul. wtr. 1220/2 0"  
D & A

Co. Lse. No. Sec. T. R.