

Section 1 Township 26 Range 6 EWell No. # 1 Planters State BankCompany G-M-R Oil

0							

NORTH

WEST

EAST

SOUTH

Butler KANSAS

SEC.	TWP.	R.
1	26	6E

WELL NO.

1 Planters State Bank

FARM

COMPANY

G-M-R Oil


CONTRACTOR

330 Ft. from N. Line

Ft. from S. Line

Ft. from E. Line

330 Ft. from W. Line

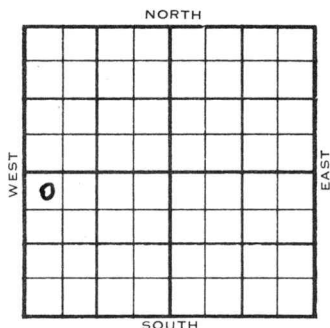

NW NW SW

Texas - DHM

	ELEVATION	REPORT
1953	1408'	

12/22 RUR

1954
1/6

Spud 12-26-59

D&A

TD 2810'

8" @ 80'

Lans 1801', KC 2097', Miss 2797'

TD 2810'

D&A

ABANDONED

Sec. **1** (Blk. Twp.) **26** (Sur. Rge.) **6E** Map No.

Operator **G-M-R Oil**

Well No. **1** Farm **Planters State Bank**

Elev.	Location	NW	NW	SW
-------	----------	----	----	----

0

FIRST REPORT

330 Ft. From N Line SW

330 Ft. From W Line Quarter

1st. Report DEC 22 1953

Completion


Remarks Texas - DHM

Spudding Date _____

Drlg. Data

R U R

J. G. McGEHEE

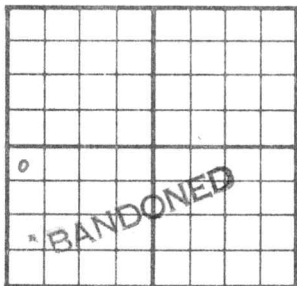County Butler State KansasSec. 1 (Blk.
Twp.) 26 (Sur.
Rge.) 6 E Map No.Operator G-M-R OilWell No. 1 Farm Planters State BankElev. 1408 Location NW NW SW330 Ft. From N Line SW330 Ft. From W Line Quarter

1st. Report

Completion JAN 8 1954

Remarks

Spudding Date 12-26-53Drlg. Data D & A TD 28108" @ 80 Lans. 1801 KC 2097Miss. 2797 TD 2810D & A