

Butler KANSAS


DX 78-1

Section 17 Township 25 Range 4E

Well No. 1 Whiteside

Company E. H. Adair & Lee Phillips

NORTH

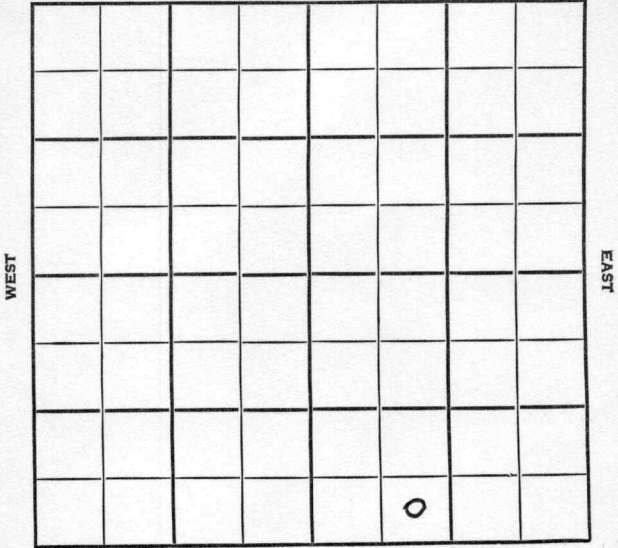

SOUTH

Butler

KANSAS

SEC.

TWP.

R.

17

25

4 E

WELL NO.

1 Whiteside

FARM

COMPANY

E. H. Adair & Lee Phillips

CONTRACTOR

Co. tools

NW Pierce Pool

Ft. from N. Line

330

Ft. from S. Line


Ft. from E. Line

990

Ft. from W. Line

SE SW SE

NORTH

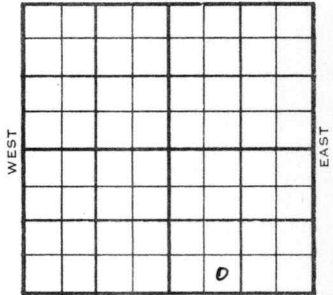

SOUTH

ELEVATION

REPORT

1954

1313'

7/14

Spud 7-11-54

8" @ 77

Drlg. 220'

8/4

Spud 7-11-54 Oil well TD 2554

8" @ 77 KC 2087 Miss. 2524


TD 2532 5" @ 2528 DD 2554

FU 1400' oil P/2 BOPH

Comp. 25 BOPD

COMPLETED

County Butler State Kansas
 Sec. 17 (Blk.) 25 (Sur.) 4E Map No.
 Operator E. H. Adair & Lee Phillips
 Well No. 1 Farm Whiteside
 Elev. 1313 Location SE SW SE

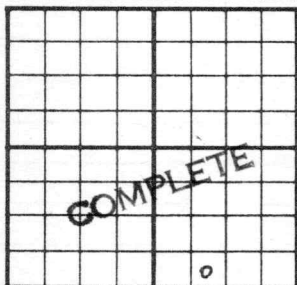

330 Ft. From S Line SE
990 Ft. From W Line Quarter
 1st. Report
 Completion AUG 4 1954
 Remarks NW Pierce Pool
Co. tools
 Spudding Date 7-11-54

Drlg. Data Oil well TD 2554
8" @ 77 KC 2087 Miss. 2524 TD 2532
5" @ 2528 DD 2554 FU 1400' oil
P/ 2 boph Comp. 25 bopd

J. G. McGEHEE