


Map No. _____ Sec. 23 Twp. 23 R. 0

Well No. 13 Hull Farm

Tidal Oil Company

NORTH

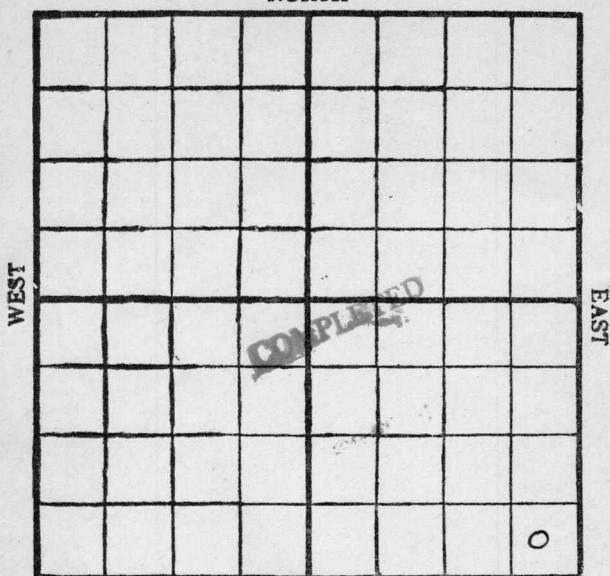

SOUTH

Location -----

Drilling Remarks:

Rig Up -----

Drilling Remarks:

RECORD

Cased----- in.----- ft.

Sand -----

Gas -----

Oil_____

Total Depth -----

PRODUCTION

1st 24 hrs. Nat.-----

1st 24 hrs. after shot-----

Gas _____ cu. ft

Dry Hole -----

Abandoned -----


Map No. K15 Sec. 35 Twp. 25 R. 8Well No. 13 HullThe Tidal Oil Company

Contractor

NORTH

WEST

EAST

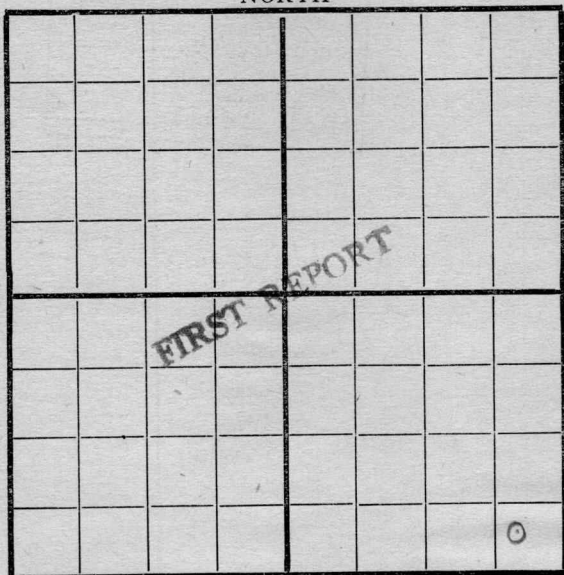

400 S

SOUTH

500 E

Location _____

Rig up ☒

Drilling and Remarks:

RECORD

Cased _____ in., _____ ft.

Sand _____

Gas _____

Oil _____

Total Depth _____

PRODUCTION

1st 24 hrs. Nat. _____

1st 24 hrs. after shot _____

Gas _____ Cu. Ft.

Dry Hole _____

Abandoned _____

Date

April 3 1919 Pyle Scout


Map No. K 15 Sec. 35 Twp. 25 R. 8Well No. 13Tidal Oil Company

Contractor

NORTH

WEST

EAST

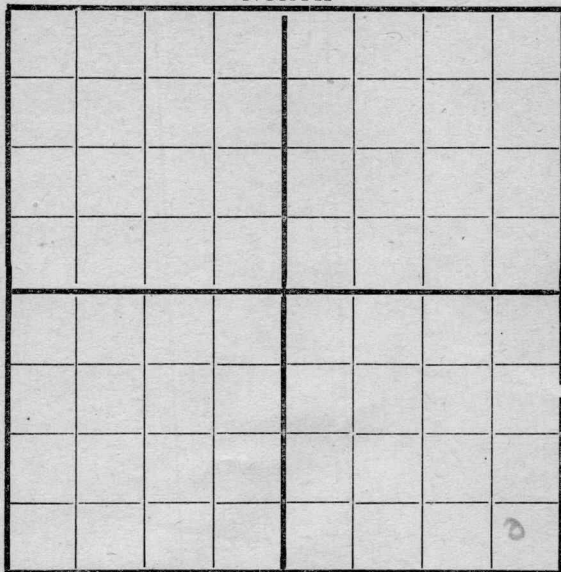

SOUTH

4005500E

Location _____

Rig up _____

Drilling and Remarks:

RECORD

Cased _____ in., _____ ft.

Sand _____

Gas _____

Oil _____

Total Depth _____

PRODUCTION

1st 24 hrs. Nat. _____

1st 24 hrs. after shot _____

Gas _____ Cu. Ft.

Dry Hole _____

Abandoned _____

Date

5/4 1919 Cyle Scout


Map No. K15 Sec. 35 Twp. 25 R. 8Well No. 13Tidal & Southern Company

Contractor

NORTH

WEST

EAST

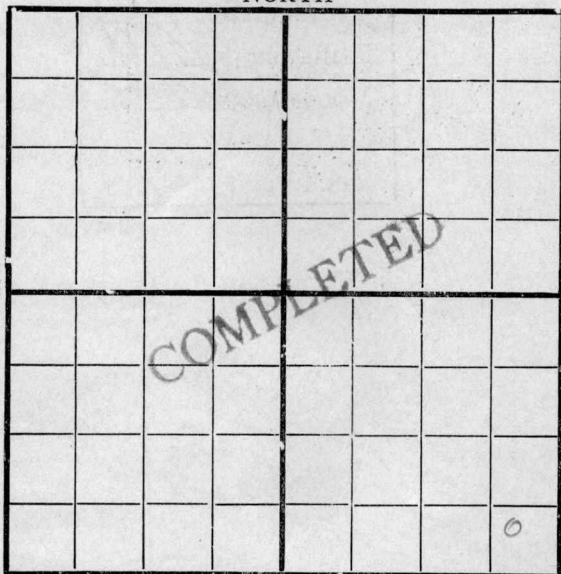

SOUTH

4003500 E

Location _____

Rig up _____

Drilling and Remarks:

Shot 80 g to

RECORD

Cased _____ in., _____ ft.

Sand 2384 - 2403

Gas _____

Oil _____

Total Depth 2407

PRODUCTION

1st 24 hrs. Nat. _____

1st 24 hrs. after shot 10 bblsGas _____ Cu. Ft. ☒

Dry Hole _____

Abandoned _____

Date

6/6

191

9Cyber

Scout