


Map No. 115 Sec. 36 Twp. 25 R. 8
 Well No. 6 Bryden Farm
Tidal Oil Company

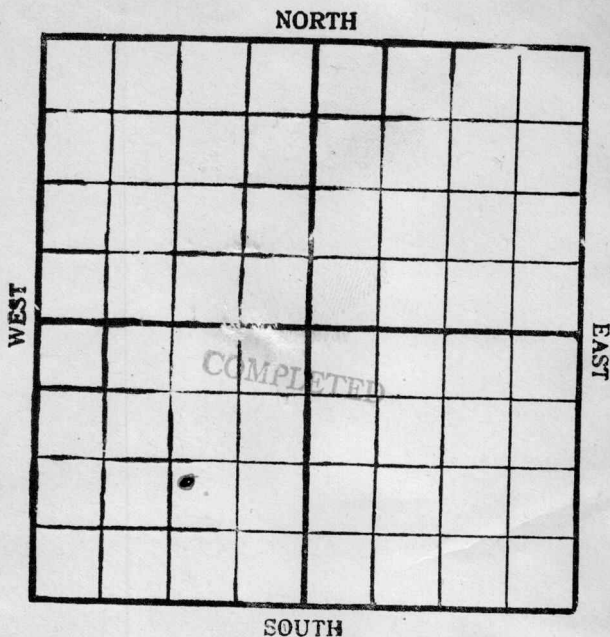

Location 11605 1070 E.

Drilling Remarks:

Rig Up

Drilling Remarks:

Shot 140 gts

RECORD

Cased _____ in. _____ ft.

Sand 2327 - 2396

Gas _____

Oil _____

Total Depth _____

PRODUCTION

1st 24 hrs. Nat. _____

1st 24 hrs. after shot 80 bbls

Gas _____ cu. ft.

Dry Hole _____

Abandoned _____


Map No. K 15 Sec. 36 Twp. 25 R. 8Well No. 6 BrydenTidal Oil Company

Contractor

NORTH

WEST

EAST

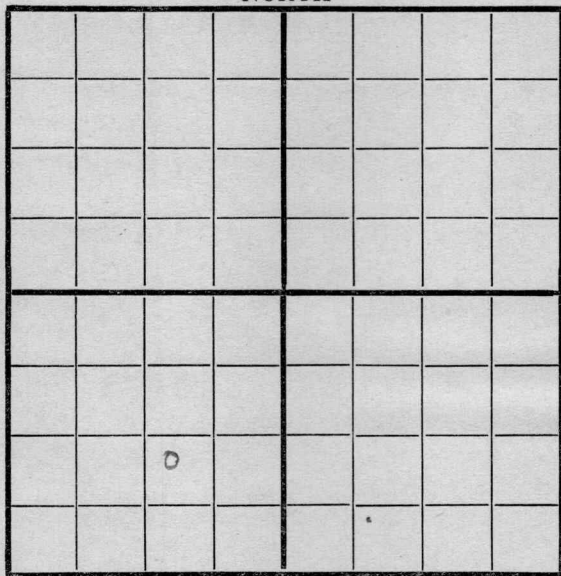

SOUTH

1160-S

1070-E

Location _____

Rig up _____

Drilling and Remarks:

400'

RECORD

Cased _____ in., _____ ft.

Sand _____

Gas _____

Oil _____

Total Depth _____

PRODUCTION

1st 24 hrs. Nat. _____

1st 24 hrs. after shot _____

Gas _____ Cu. Ft.

Dry Hole _____

Abandoned _____

Date

11/18

1918

Oyler

Scout


Map No. K15 Sec. 36 Twp. 25 R. 8Well No. 6 Bryden
Tidal Oil Company

Contractor

NORTH

WEST

EAST

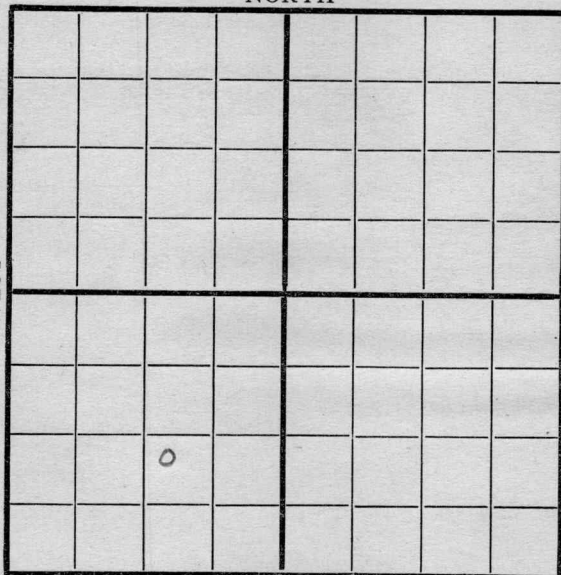

SOUTH

1160-S

1070-E

Location _____

Rig up _____

Drilling and Remarks:

12 1/2' @ 900'

RECORD

Cased _____ in., _____ ft.

Sand _____

Gas _____

Oil _____

Total Depth _____

PRODUCTION

1st 24 hrs. Nat. _____

1st 24 hrs. after shot _____

Gas _____ Cu. Ft.

Dry Hole _____

Abandoned _____

Date

Pyle

1918

Scout

11/26


Map No. K15 Sec. 36 Twp. 25 R. 8Well No. 6 Brydlen
Tidal Oil Company

Contractor

NORTH

WEST

EAST

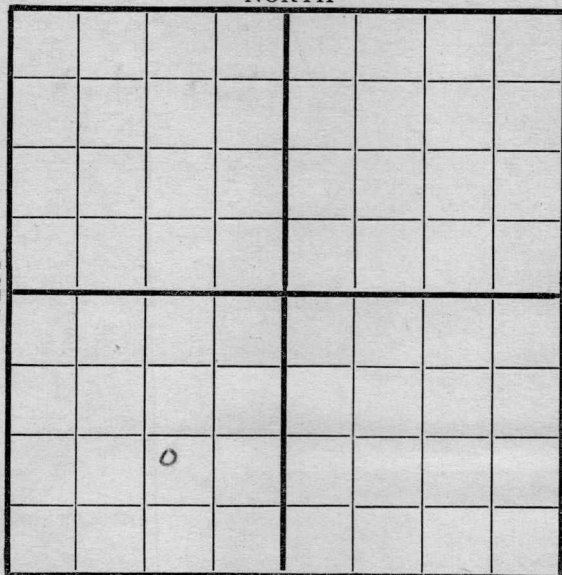

SOUTH

1160-S

1070-E

Location _____

Rig up _____

Drilling and Remarks:

RECORD

Cased _____ in., _____ ft.

Sand _____

Gas _____

Oil _____

Total Depth _____

PRODUCTION

1st 24 hrs. Nat. _____

1st 24 hrs. after shot _____

Gas _____ Cu. Ft.

Dry Hole _____

Abandoned _____

Date

12/2 1918 Cyph Scout


Map No. K15 Sec. 36 Twp. 25 R. 8Well No. 6 Bryden
Tidal Oil Company

Contractor

NORTH

WEST

EAST

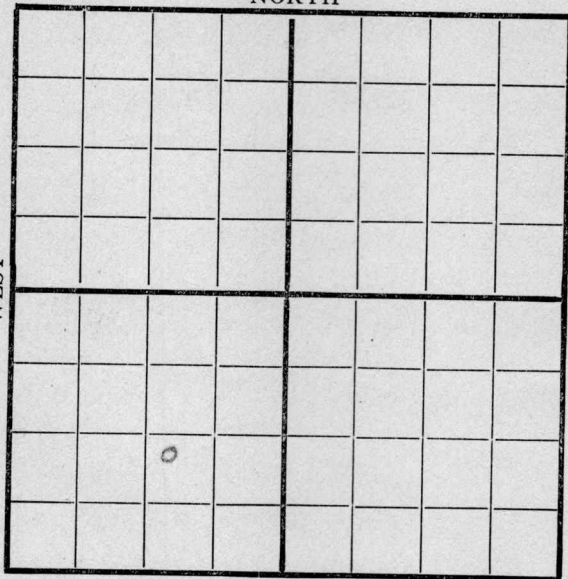

SOUTH

1160-5

1070-E

Location _____

Rig up _____

Drilling and Remarks:

1235'

RECORD

Cased _____ in., _____ ft.

Sand _____

Gas _____

Oil _____

Total Depth _____

PRODUCTION

1st 24 hrs. Nat. _____

1st 24 hrs. after shot _____

Gas _____ Cu. Ft.

Dry Hole _____

Abandoned _____

Date

12/9

1918

H. B.

Scout

Map No. K15 Sec. 36 Twp. 25 R. 8
 Well No. 6 Bryden
Tidal Oil Company
 Contractor

NORTH							
WEST							
SOUTH							
1160-S				1070-E			

Location _____

Rig up _____

Drilling and Remarks:

RECORD

Cased _____ in., _____ ft.

Sand _____

Gas _____

Oil _____

Total Depth _____

PRODUCTION

1st 24 hrs. Nat. _____

1st 24 hrs. after shot _____

Gas _____ Cu. Ft.

Dry Hole _____

Abandoned _____

Date

12/17 1918 Pyle Scout


Map No. K15 Sec. 36 Twp. 25 R. 8Well No. 6 Bryden
Tidal Oil Company

Contractor

NORTH

WEST

EAST

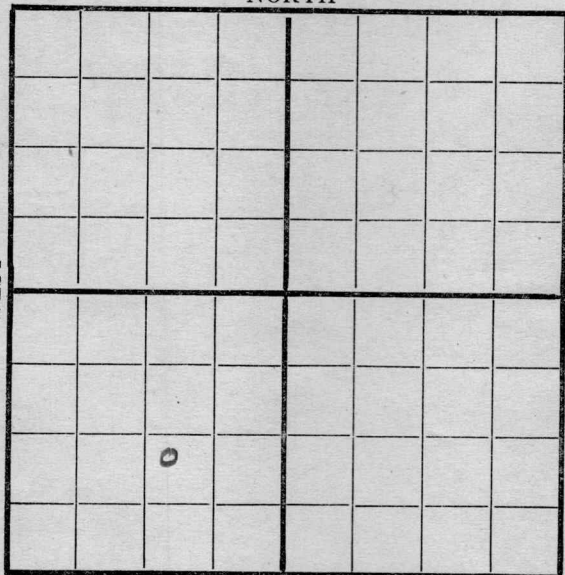

SOUTH

1160. S

1070. E

Location _____

Rig up _____

Drilling and Remarks:

RECORD

Cased _____ in., _____ ft.

Sand _____

Gas _____

Oil _____

Total Depth _____

PRODUCTION

1st 24 hrs. Nat. _____

1st 24 hrs. after shot _____

Gas _____ Cu. Ft.

Dry Hole _____

Abandoned _____

Date

12/24 1918

Pyle

Scout


Map No. K15 Sec. 36 Twp. 25 R. 8Well No. 6 Brydens
Tidal Oil Company

Contractor

NORTH

WEST

EAST

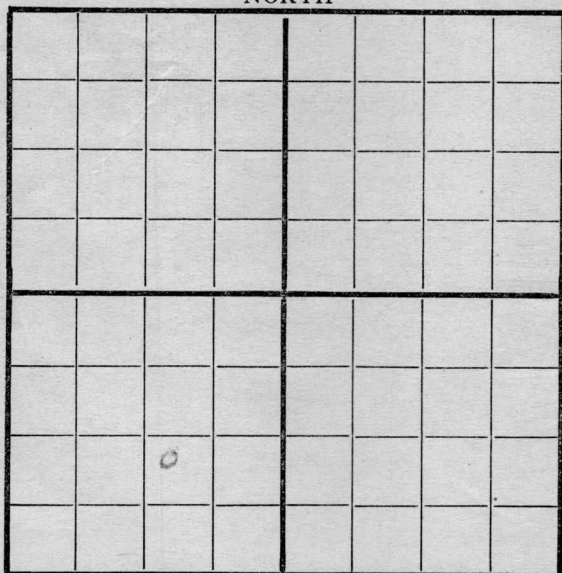

SOUTH

1160 S

1070 E

Location _____

Rig up _____

Drilling and Remarks:

D. O @
1550'

RECORD

Cased _____ in., _____ ft.

Sand _____

Gas _____

Oil _____

Total Depth _____

PRODUCTION

1st 24 hrs. Nat. _____

1st 24 hrs. after shot _____

Gas _____ Cu. Ft.

Dry Hole _____

Abandoned _____

Date

Jan 17 1918

Pyle

Scout


Map No. K15 Sec. 36 Twp. 25 R. 8Well No. 6 BrydenTidal Oil Company

Contractor

NORTH

WEST

EAST

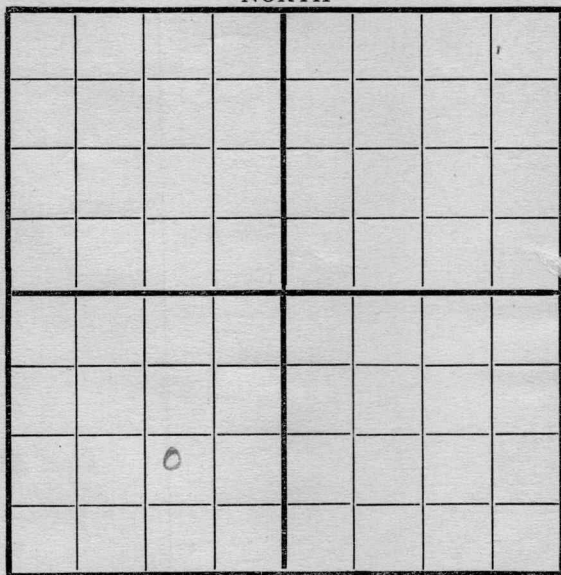

1160 S

SOUTH

1070 E

Location

Rig up

Drilling and Remarks:

1900'

RECORD

Cased _____ in., _____ ft.

Sand _____

Gas _____

Oil _____

Total Depth _____

PRODUCTION

1st 24 hrs. Nat. _____

1st 24 hrs. after shot _____

Gas _____ Cu. Ft.

Dry Hole _____

Abandoned _____

Date

Jan 23 1919

Pyle Scout


Map No. K15 Sec. 36 Twp. 25 R. 8Well No. 6 BrydenTidal Oil Company

Contractor

NORTH

WEST

EAST

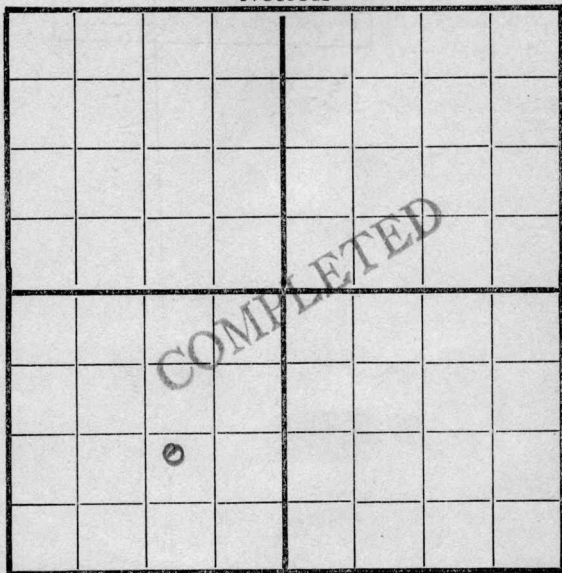1160 S

SOUTH

1070 E

Location _____

Rig up _____

Drilling and Remarks:

Shot 140 gals

RECORD

Cased _____ in. _____ ft.

Sand 2327-2396

Gas _____

Oil _____

Total Depth _____

PRODUCTION

1st 24 hrs. Nat. _____

1st 24 hrs. after shot 80 B.

Gas _____ Cu. Ft.

Dry Hole _____

Abandoned _____

Date

Feb 4 1919 Cyle Scout