KANSAS


FORM 51 5M 6-46 PETROL

Butler County

Section 27 Township 26 Range 6E

Well No. 1 Kristler

Company Dunnet Strait

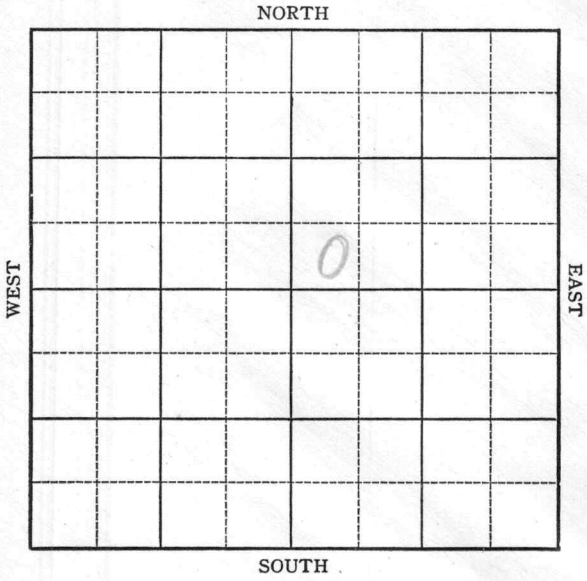

FORM 252-A
5M 6-46 PETROL

KANSAS Butler County ✓

Sec. 27 Twp. 26 R. 6E

Well No. #1 Kristler Farm

Dunnet Strait Company

Miscellaneous


Ft. from N. Line

330 Ft. from S. Line

Ft. from E. Line

330 Ft. from W. Line

SW NE

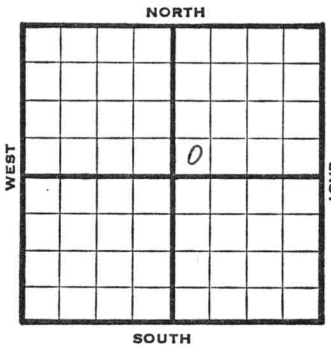

1946	REPORT
	Elev. 1423'
8/7	Machine
8/13	Spud
8/20	12½" @ 835 CO
8/27	Drlg 1500'
9/5	10" @ 1665'
	Lans 1835
	KC 2145'
	8" @ 2190'
	Drlg 2230'
9/10	6" @ 2465
	Drlg 2615'
9/18	Miss 2804'
	TD 2829'
	Water

ABANDONED

FORM 56 200 BKS. 1-44 PETROL

Pool Name Miscellaneous

KANSAS Kansas

Map No. 14 Sec. 27 Twp. 26 R. 6E


Well No. 1 Kristler

Dunnet Strait Company

FIRST REPORT Contractor

SW NE

SECTION PLAT

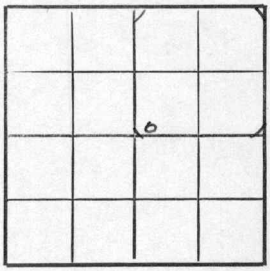

____ Ft. from N. Line

330 Ft. from S. Line

____ Ft. from E. Line

330 Ft. from W. Line

Butler County

Location

Rig up

Drilling and Remarks:

Machine

RECORD

Cased ____ in., ____ ft.

Sand

Gas

Oil

Total Depth

PRODUCTION

1st 24 hrs. Nat.

1st 24 hrs. after shot

Gas Cu. Ft.

Dry Hole

Abandoned

Date

AUG 7 1946

19 S. J. LEWIS Scout

FORM 56 200 BKS. 1-44 PETROL

KANSAS / Kansas Pool Name Miscellaneous

Map No. 14 Sec. 27 Twp. 26 R. 6E


Well No. 1 Kistler

Dunney Strait Company

ABANDONED Contractor

SW NE E 1,143

SECTION PLAT

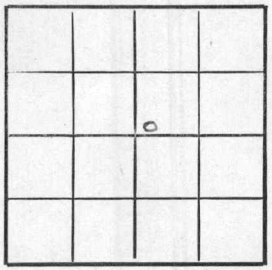

Ft. from N. Line

330 Ft. from S. Line

Ft. from E. Line

330 Ft. from W. Line

Butler County

Location

Rig up

Drilling and Remarks:

Mis 2804

Water

RECORD

Cased in., ft.

Sand

Gas

Oil

Total Depth 2829

PRODUCTION

1st 24 hrs. Nat.

1st 24 hrs. after shot

Gas Cu. Ft.

Dry Hole

Abandoned

Date

SEP 18 1946 19

S. J. LEWIS Scout