

Abandoned.....

Map No. KANSAS Sec. 23 Twp. 26 R. 6E


Well No. # Jones McCallan Farm
Phillips Twin Drilling Co. Ed. Quinn Company

 Ft. from N. Line

330 Ft. from S. Line

330 Ft. from E. Line

 Ft. from W. Line

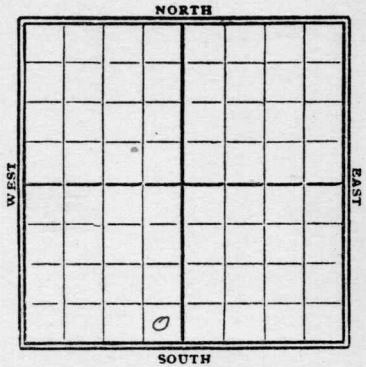

1929

Date	1433 DF	REPORT
2/20	Ro G.	
2/27	Timbers	
3/6	Rig	
3/13	Spudding	
3/20	Spdg 340'	
3/27	Drly 895'	
4/3	" 1205'	
4/10	" 1930'	
4/17	" 2500'	
4/24	Chat 2778-90'	
	show oil 2790'	
	" " 2822-35	
	drly 2885'	
5/1	" 2970'	
5/8	Base line 3100 drly	
5/15	Iron line 3170-75'	
	VIR 5" - 3233'	
5/22	T.D. 3305'	
	dry & abandoned	
		OVER

1956

O.W.W.O.

8-1 Old info → Old cable tool hole;
Wash down SO 2811, SO 2832-85;
OTD 3305; D&A
NEW INFORMATION: Wash down to 2922;
5" @ 2910'
M. 2790'

8-22 28/2886-93
PB 2877 30/2833-38
S/ 9 BO ≠ 50 BWPD
PB 2810 40/2780-90
S/ 8 BO ≠ 2 BWPD
P/ 8 BOPD ≠ 23 BWPD
M. 2779';
TD 3305'

COMPLETED

Butter

K14 KANSAS Sec. 23 Twp. 26 R. 6

Well No. 1 Mc Cellan
Phillips & Shell Pet Company

Contractor

FIRST REPORTS

SECTION PLAT

Ft. from N. Line

330 Ft. from S. Line

330 Ft. from E. Line

Ft. from W. Line

Location Rob

Rig up

Drilling and Remarks:

RECORD

Cased.....in.,ft.

Sand.....

Gas.....

Oil.....

Total Depth.....

PRODUCTION

1st 24 hrs. Nat.....

1st 24 hrs. after shot.....

Gas.....Cu. Ft.

Dry Hole.....

Abandoned.....

Date

FEB 20 1929

192

CHAS. L. SHERWOOD

Scout

14 **KANSAS** Sec. *23* Twp. *26* R. *6*

Well No. *1 The Chellan*

Phillips & Steel Company

Contractor

COMPLETE

SECTION PLAT

.....Ft. from N. Line

330 Ft. from S. Line

330 Ft. from E. Line

.....Ft. from W. Line

ABANDONED

Location.....

Rig up.....

Drilling and Remarks:

RECORD

Cased.....in.,ft.

Sand.....

Gas.....

Oil.....

Total Depth *3305*

PRODUCTION

1st 24 hrs. Nat.....

1st 24 hrs. after shot.....

Gas.....Cu. Ft.

Dry Hole ☒

Abandoned ☒

Date

MAY 22 1929

CHAS. L. SHERWOOD

192

Scout

O.W.W.O.

FORM 513 SUNRAY

County Butler Elev. 1433DF
 Sec. 23 Twp. 26S Rge. 6E
 Company Twin Drlg. (Ed Dunn)
 FarmName Jones No. 1
 OWWO

TOPS	DEPTH	LOG	DATUM	Loc. in Sec.
Anh.				SE SE SW
T.P.				
H.				
Tr.				
Dg.				
B.L.				
L.				Geol.
K.C.				Contr.
B.K.C.				Augusta Drlg
Ce.				Pool
C.	2790			W.C.
M.				
M.				
K.				
Mz.				
Ma.				
V.				
S.				
S.				
A.				
R.				
Pf.				
G.				
T.D.				

FIRST REPORT

Date Comm. AUG 1 1956
 Old info - Old cable tool hole; wash down
 SO 2811, SO 2832-85; OTD 3305; D & A
 New info - Wash down to 2922; 5" 2910;

2221 8 JUA

58

G.R.

County Butler Elev. 1433DF
 Sec. 23 Twp. 26S Rge. 6E
 Company Twin Drlg. (Ed Dunn)
 Farm Name Jones No. 1
 OWWO

TOPS	DEPTH	LOG	DATUM	Loc. in Sec.
Anh.				SE SE SW
Tp.				
H.				
Tr.				
Dg.				
Bl.				
L.				Geol.
K.C.				Contr.
B.K.C.				Augusta Drlg
Ce.				Pool
C.	<u>2779</u>	<u>2790</u>		W.C.
M.				
M.				
K.				
Mz.				
Ma.				
V.				
S.				
S.				
A.				
R.				
Pe.				
G.				
T.D.		<u>3305</u>		

AUG 22 1956

Date Comm.

Old info - Old cable tool hole; wash down

SO 2811, SO 2832-35; OTD 3305; D & A

New info - Wash down to 2922; 5" 2910; 05

AUG 8 '56 28/2886-93 N.S. PB 2877

30/2833-38 (2) AUG 15 '56 ✓ AUG 22 '56

8 9 B0 + 50 Bwpd PB 2810

40/2780-90 8 8 B0 + 2 Bwpd

Pop. P. 8 B0pd + 23 Bwpd.