

Sedgwick


KANSAS

SECTION 4 TOWNSHIP 27 RANGE 1E

WELL NO. #2 Derby SWD

COMPANY Derby Refg.

NORTH

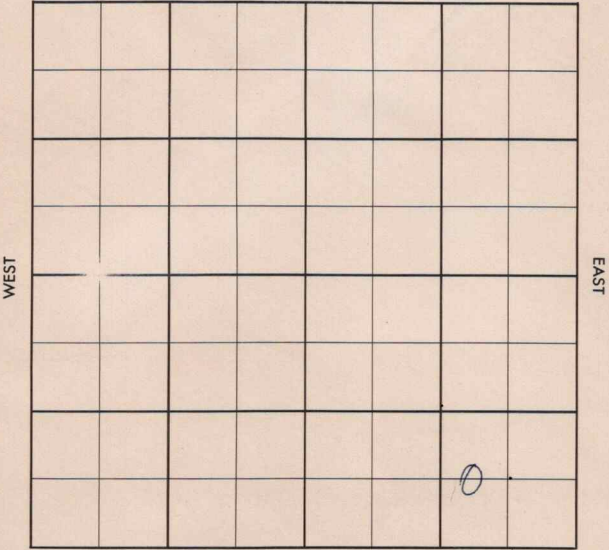

SOUTH

523875

FORM 513 SUNRAY

County Sedgwick Elev. \_\_\_\_\_  
 Sec. 4 Twp. 27 Rge. 1E  
 Company Derby Ref.  
 Farm Name Derby SWD No. 2

TOPS	DEPTH	LOG	DATUM	Loc. in Sec.
Anh.				W $\frac{1}{2}$ SE SE
Tp.				660' SL
H.				950' EL
Tr.				
Dg.				
Bl.				
L.				Geol. _____
K.C.				Contr. _____
B.K.C.				Sierra
Ce.				
C.				Pool
M.				Wichita
M.				
K.				
Mz.				
Ma.				
V.				
S.				
S.				
A.				
R.				
Pf.				
G.				
T.D.				

DEC 19 56  
 FIRST REPORT  
 0

Date Comm. 12-13-56  
10" @ 399 drlg. 507

~~29~~

County Sedgwick Elev. 1313 DF  
 Sec. 11 Twp. 27 Rgs. 1E  
 Company Derby Ref.  
 Farm Name Derby SWD No. 2

TOPS	DEPTH	LOG	DATUM	Loc. in Sec.
Anh.	<i>Direct</i>	<i>vertic</i>		<u>W 1/2 SE SE</u>
Tp.				
H.				
Tr.				<u>660' SL</u>
Dg.				
Bl.				<u>950' EL</u>
L.				
K.C.	<u>2704</u>	<u>2515</u>		Geol. _____
B.K.C.				Contr. _____
Ce.				<u>Sierra</u>
C.				
M.	<u>3210</u>	<u>2981</u>		Pool _____
M.				<u>Wichita</u>
K.				
Mz.				
Me.				
V.	<u>3581</u>	<u>3317</u>		<b>ABANDONED</b>  FEB 6 '57  0
S.				
S.				
A.	<u>3688</u>	<u>3415</u>		
R.				
Pe.				
G.				
TD.	<u>4204</u>	<u>3899</u>		

Date Comm. 12-13-56

10" @ 399 drlg. 507 DEC 26 '56 ✓ JAN 2 '57  
Ø JAN 9 '57 ✓ JAN 18 '57 Ø 3900  
JAN 23 '57 ✓ JAN 30 '57 DST 3579-87 1hr  
30' oil + 2245' VSO CW 1BHP  
1320 FBHP 1290/30 DST 3640-48  
1hr 60' oil + 65' SOCM 1BHP 1345  
130" DST 3651-67 1hr 60' Ø Md  
1BHP 500 FBHP 1368/30 DST 3668-75  
1hr 140' Mdy sulphwtr 1BHP 1290/30

DST 3681-97 1hr 265' MSW  
 Press Failed <sup>vertical</sup> 7' @ <sup>directional</sup> 3750 MICT  
 CO <sup>4204</sup> ~~3899~~  $\wedge$  ~~50~~ ~~150~~ ~~150~~  
 18 ~~input~~ ~~input~~ input +st of  
 6 BWP minute. FEB 6 '57

Target 1250' NW of Logo

no ~~7~~ simpson top  
 complete for SWD well.