
FORM 51 25M 3-49 PETROL

Pawnee KANSAS

Section 24 Township 20 Range 16W

Well No. #4 Deckert "C"

Company Stanolind

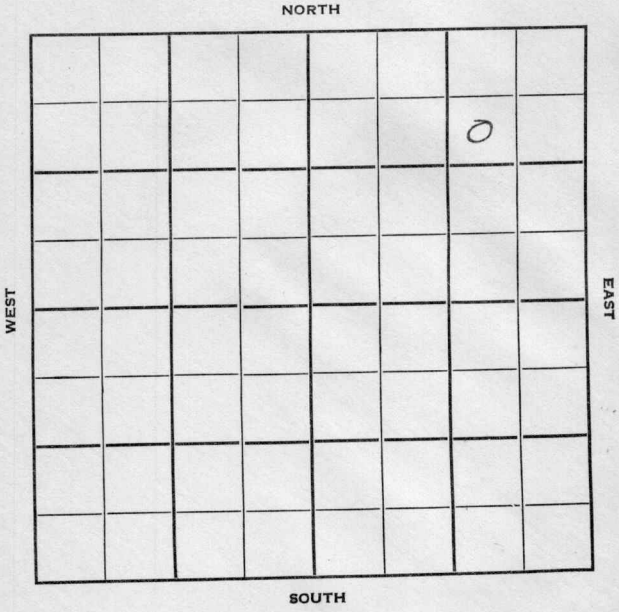

FORM 252-B
10M 9-49 PETROL

HOT FILE

Pawnee KANSAS

Sec. 24 Twp. 20 R. 16W

Well No. #4 Deckert "C" Farm

Stanolind Company

Contractor

Pawnee Rock


990' Ft. from N. Line

Ft. from S. Line

990' Ft. from E. Line

Ft. from W. Line

SW NE NE

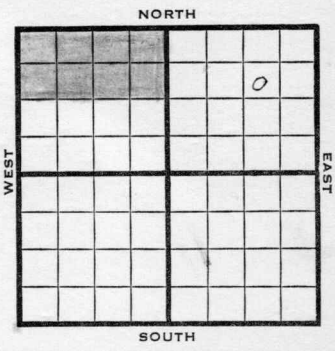

1950	Elev 2084' REPORT
2/8	Location
3/22	Anhy 1086' 8 5/8" @ 1095' Heebner 3408' Lans 3502' Arb. 3778' DST 3779-95 Rec 10' oil 70' Oil cut mud 700' wtr. DST 3794-3800 Rec 240' oil cut mud 360' wtr. DST 3800-05' Rec 15' oil 85' oil cut mud 270' wtr. DST 3805-10 Rec 60' oil cut mud 400' wtr. DST 3809-15' Rec 300' oil 60' oil cut mud 300' wtr. DST 3814-20 Rec show gas 30' oil cut mud 100' oil 580' wtr. 5½" @ 3816'

OVER

1950

3/22 Information brought forward

TD 3820'
Swb 6 Oil 8wtr ph
Swb 4 Oil 8 wtr 8 hrs.
Squeeze off
PB 3813'
4 shots 3810-11
250 acid
Bail 2 gal oil 1 gal wtr ph
500 acid
Swab 2½ B Oil
8 BW ph
PB 3800
8 shots 3794-96
Bail 1 BWPH
250 acid
Swab 7 BWPH
2500 acid
Comp 48 BOPD
Comp

COMPLETED

Form 26 200 Bks. 11-49 Petrol

Kansas

Pawnee Rock

Map No. _____ Sec. 24 Twp. 20 R. 16W

Well No. 4 Deckert "C"

Stanolind Company

Contractor

SW NE NE

990 Ft. from N. Line


_____ Ft. from S. Line

990 Ft. from E. Line

_____ Ft. from W. Line

Pawnee County

SECTION PLAT

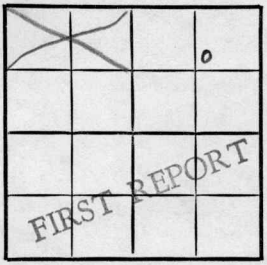

Location X

Rig up

Drilling and Remarks:

RECORD

Cased _____ in., _____ ft.

Sand

Gas

Oil

Total Depth

PRODUCTION

1st 24 hrs. Nat.

1st 24 hrs. after shot

Gas _____ Cu. Ft.

Dry Hole

Abandoned

Date

FEB 8 1950 19

J. E. TYRA Scout

Form 26 200 Bks. 11-49 Petrol

Kansas

Pawnee Rock Pool

Map No. _____ Sec. 24 Twp. 20 R. 16W

Well No. 4 Deckert "C"


Stanolind Company

Contractor

SW NE NE

El. 2084

SECTION PLAT

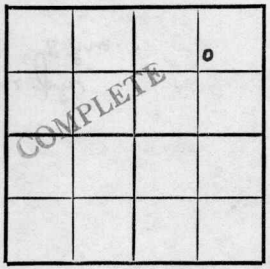

990 Ft. from N. Line

Ft. from S. Line

990 Ft. from E. Line

Ft. from W. Line

Pawnee County

Location

Rig up

Drilling and Remarks:

Anhy 1086
8 5/8" C 1095
Heebner 3408
Lans. 3502
ark. 3778
D.ST. 3779-95
Rec 10' oil
70' oil cut mud
700' water

RECORD

Cased in., ft.

Sand

Gas

Oil

Total Depth

PRODUCTION

1st 24 hrs. Nat.

1st 24 hrs. after shot

Gas Cu. Ft.

Dry Hole

Abandoned

Date

MAR 22 1950 19

J. E. TYRA Scout

DST 3794-3800
Rec. 240' oil cut mud
360' water
DST 3800-05
Rec. 15' oil
85' oil cut mud
270' water
DST 3805-10
Rec. 60' oil cut mud
400' water
DST 3809-15
Rec. 300' oil
60' oil cut mud
300' water
DST 3814-20
Rec. show gas
30' oil cut mud
100' oil
580' water
5½" @ 3816
T.D. 3820
Swab 6 oil 8 water ph
" 4 oil 8 " 8 hrs.
Squeeze off
PB 3813
4 shots 3810-11
250 acid
Bail 2 gal. oil 1 gal. water ph.
500 acid
Swab 2½ B oil 8 B W ph
PB 3800
8 shots 3794-96
Bail 1 bwph
250 acid
Swab 7 bwph
2500 acid
Comp. 48 bopd

Scout Cards
Land Small Map
Land Wall Map
Tracings
Trance Map
Pierce Map
Misc.