


Map No. Kansas Sec. 2 Twp. 21 R. 6 W.
 Well No. 2 - Watson (Walster) Farm
Frankers et al Company
 INDEPENDENT O. & G.
 NORTH

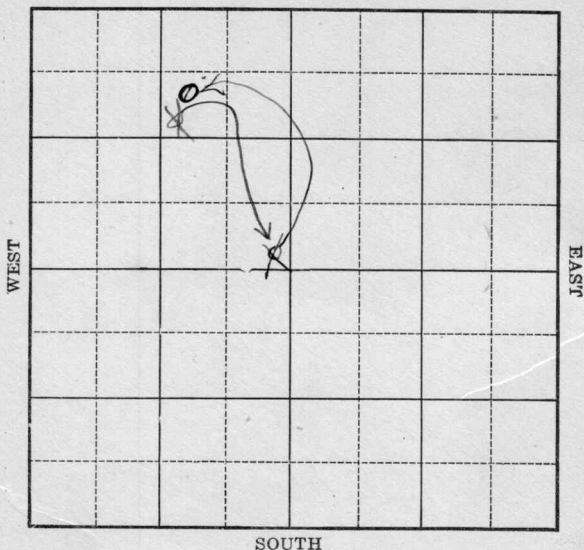

Location _____

Drilling Remarks _____

Rig Up _____

Drilling Remarks _____

RECORD


Cased _____ in. _____ ft.
 Sand _____
 Gas _____
 Oil _____
 Total Depth _____

PRODUCTION

1st 24 hrs. Nat. _____
 1st 24 hrs. after shot _____
 Gas _____ cu. ft.
 Dry Hole _____
 Abandoned _____

Map No. Kansas Sec. 2 Twp. 21 R 6^WWell No. 2 Walsten FarmGardner Company
INDEPENDENT~~990~~ Ft. from N. Line200 Ft. from S. Line200
~~990~~ Ft. from E. Line

Ft. from W. Line

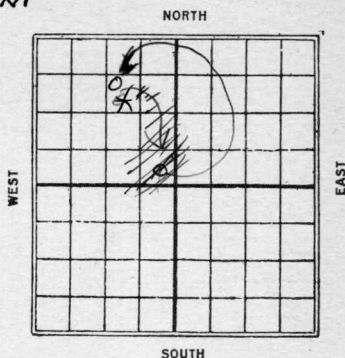

Date	REPORT
3/17	Location
4/14	Spud.
4/21	
4/29	Dlg 750
5/5	" 1580'
5/12	T.D. 2349. Shut down. for "eight"
5/26	Set 8" at 2349
6/2	Drlg 2600
6/9	" 2788
6/16	" 2910
6/23	S.D. 2910'
6/30	Drlg - 3170
7/14	Chat 3363-3408 oil 3375 1200 bbls 35-Gyr.
7/21	T.D. 3408 making 971 bbls.
7/28	Top chat 3363 Oil 3375 T.D. 3445 1200 bbls

no base
 Map No. **KANSAS** Sec. 2 Twp. 21 R. 6W

Well No. 2. Valsten

Yunker et al Company

Contractor

SECTION PLAT

990 Ft. from N. Line

_____ Ft. from S. Line

990 Ft. from E. Line

_____ Ft. from W. Line

	0		

FIRST REPORTS

Location _____

Rig up _____

Drilling and Remarks:

Location.

RECORD

Cased _____ in., _____ ft.

Sand _____

Gas _____

Oil _____

Total Depth _____

PRODUCTION

1st 24 hrs. Nat. _____

1st 24 hrs. after shot _____

Gas _____ Cu. Ft.

Dry Hole _____

Abandoned _____

Date

MAR 17 1926

192

S. J. LEWIS

Scout

Map No. ~~KANSAS~~ Sec. 2 Twp. 21 R. 6 W

Well No. 2 Walsten

Yonker & Co. Company

Contractor

SECTION PLAT

	0		
	0		

_____ Ft. from N. Line

200 Ft. from S. Line

200 Ft. from E. Line

_____ Ft. from W. Line

Correction

Location _____

Rig up _____

Drilling and Remarks:

Rig
Reported L. BH.
NE NW. should
be SE NW.

RECORD

Cased _____ in., _____ ft.

Sand _____

Gas _____

Oil _____

Total Depth _____

PRODUCTION

1st 24 hrs. Nat. _____

1st 24 hrs. after shot _____

Gas _____ Cu. Ft.

Dry Hole _____

Abandoned _____

Date

MAR 24 1912

S. J. LEWIS

Scout

Map No. KANSAS Sec. 2 Twp. 21 R. 6 W

Well No. 2 Valsten

Yonker & Co. Company

Contractor

SECTION PLAT

	0		

290 Ft. from N. Line

_____ Ft. from S. Line

290 Ft. from E. Line

_____ Ft. from W. Line

COMPLETED

Location _____

Rig up _____

Drilling and Remarks:

Top @ 3363

Oil 3375

TI 3445

1200 886

Nat.

RECORD

Cased _____ in., _____ ft.

Sand _____

Gas _____

Oil _____

Total Depth _____

PRODUCTION

1st 24 hrs. Nat. _____

1st 24 hrs. after shot _____

Gas _____ Cu. Ft.

Dry Hole _____

Abandoned _____

Date

JUL 28 1921

S. J. LEWIS

Scout

MAP No. KANSAS SEC. 2 TWP. 21 S R. 6 W

WELL No. 2 Halper

Yonkers COMPANY

churns with CONTRACTOR

SECTION PLAT

_____ FT. FROM N. LINE

_____ FT. FROM S. LINE

_____ FT. FROM E. LINE

_____ FT. FROM W. LINE

LOCATION _____

RIG UP _____

DRILLING AND REMARKS:

3365 } chat
3470 }
550 bbls
34.6.

RECORD

CASED _____ IN. _____ FT.

SAND _____

GAS _____

OIL _____

TOTAL DEPTH 3470

PRODUCTION

1ST 24 HRS. NAT. _____

1ST 24 HRS. AFTER SHOT _____

GAS _____ CU. FT.

DRY HOLE _____

ABANDONED _____

DATE

8/17 6

192

SCOUT

Map No. KANSAS Sec. 2 Twp. 21 R. 6 W

Well No. 2 Walton

Independence & O & G Company

Contractor

SECTION PLAT

	0		

990 Ft. from N. Line

_____ Ft. from S. Line

990 Ft. from E. Line

_____ Ft. from W. Line

Correction on well
Completed.

Location _____

Rig up _____

Drilling and Remarks:

Reported this
in SE NW.
should be
SW. NE NW.
and Independence
O & G. has taken
this over

RECORD

Cased _____ in., _____ ft.

Sand _____

Gas _____

Oil _____

Total Depth _____

PRODUCTION

1st 24 hrs. Nat. _____

1st 24 hrs. after shot _____

Gas _____ Cu. Ft.

Dry Hole _____

Abandoned _____

Date

DEC 21 1926

192

S. J. LEWIS

Scout