
FORM 51 25M 3-49 PETROL Greenwood KANSAS

Section 11 Township 25 Range 8E

Well No. #1 Jackson

Company Lee Cody et al

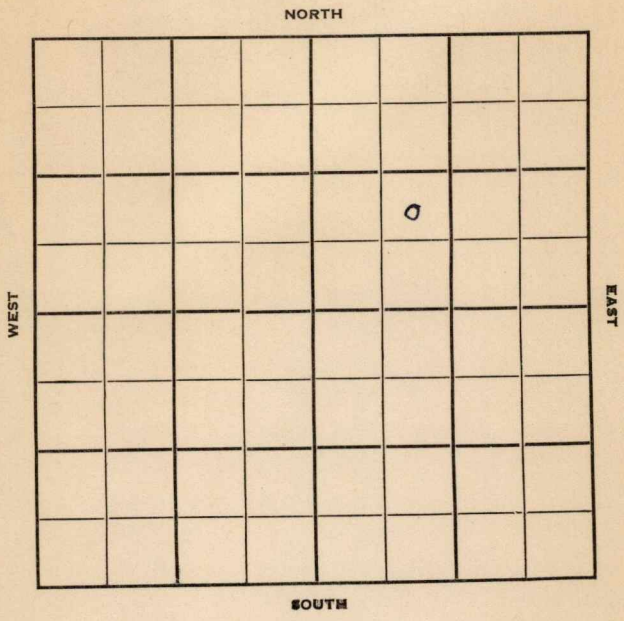

FORM 252-B
10M 11-50 PETROL

Greenwood

KANSAS ✓

Sec. 11 Twp. 25 R. 8E

Well No. #1 Jackson Farm

Lee Cody et al Company

Contractor


Ft. from N. Line

990 Ft. from S. Line

Ft. from E. Line

990 Ft. from W. Line

NE SW NE

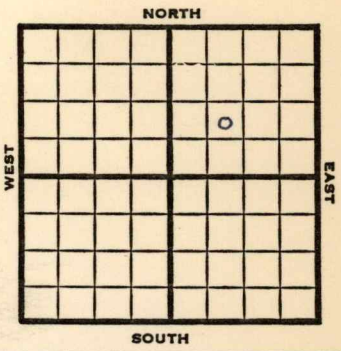

1952	Elev. - REPORT
10/15	Spud 9-25-52 Bart. 2305' TD 2307' 5" @ 2306'
12/17	Spud 9-25-52 Oil Well TD 2307' Bart 2305 TD 2307 5" @ 2306' CO to 2307 Comp. 5 bopd

COMPLETED

FORM 275 FOR SALE BY KANSAS BLUE PRINT CO.


County Greenwood State Kansas

Sec. 11 (Blk. Twp.) 25 (Sur. Rge.) 8E Map No.

Operator Lee Cody etal.

Well No. 1 Farm Jackson

Elev. Location NE SW NE

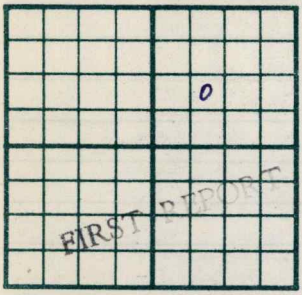

990 Ft. From S Line NE

990 Ft. From W Line Quarter

1st. Report OCT 15 1952

Completion

Remarks

Spudding Date 9-25-52

Drlg. Data

Bart. 2305 TD 2307 5" @ 2306

J. G. McGEHEE

FORM 275 FOR SALE BY KANSAS BLUE PRINT CO


County Greenwood State Kansas

Sec. 11 (Blk. Twp.) 25 (Sur. Rge.) 8E Map No.

Operator Lee Cody etal.

Well No. 1 Farm Jackson

Elev. Location NE SW NE

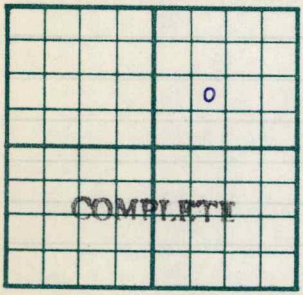

990 Ft. From S Line NE

990 Ft. From W Line Quarter

1st. Report

Completion DEC 17 1952

Remarks

Spudding Date 9-25-52

Drlg. Data Oil well TD 2307

Bart. 2305 TD 2307 5" @ 2306

CO to 2307 Comp. 5 bopd

J. G. McGEHEE