


Map No. _____ Sec. 11 Twp. 25 R. 8
Well No. ✓ Trishgraben Farm _____
Roth et al Company _____

NORTH

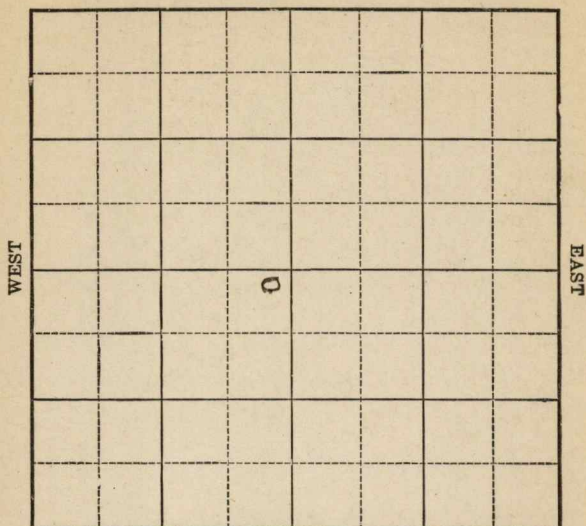

SOUTH

Location _____

Drilling Remarks:

Rig Up _____

Drilling Remarks:

RECORD

Cased _____ in. _____ ft.

Sand _____

Gas _____

Oil_____

Total Depth_____

PRODUCTION

1st 24 hrs. Nat. _____

1st 24 hrs. after shot_____

Gas _____ cu. ft.

Dry Hole _____

Abandoned _____

Map No. 25 Sec. 11 Twp. 25 R. 8


Well No. 2 Teschgraber Farm
Roth Echal Company

200 Ft. from N. Line

_____ Ft. from S. Line

200 Ft. from E. Line

Ft. from W. Line

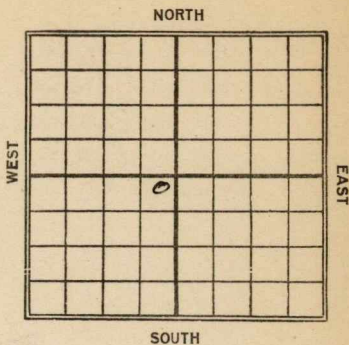

Date 1924

REPORT

1/15 Begun up
4/2 DE 9. 2351

Map No. Sec. 11 Twp. 25 R. 8

Well No. - 2 Tiesgraph

Rath et al Company

Contractor

FIRST REPORT

SECTION PLAT

200 Ft. from N. Line

_____ Ft. from S. Line

200 Ft. from E. Line

_____ Ft. from W. Line

	0		

Location _____

Rig up _____

Drilling and Remarks:

Rig up

RECORD

Cased _____ in., _____ ft.

Sand _____

Gas _____

Oil _____

Total Depth _____

PRODUCTION

1st 24 hrs. Nat. _____

1st 24 hrs. after shot _____

Gas _____ Cu. Ft.

Dry Hole _____

Abandoned _____

Date

JAN 15 1924


M. A. BENEAR

Map No. **KANSAS** ¹⁵ Sec. 11 Twp. 25 R. 8Well No. 2 Tushgraber Farm

Company

200 from N. NORTH 200 from E.

WEST

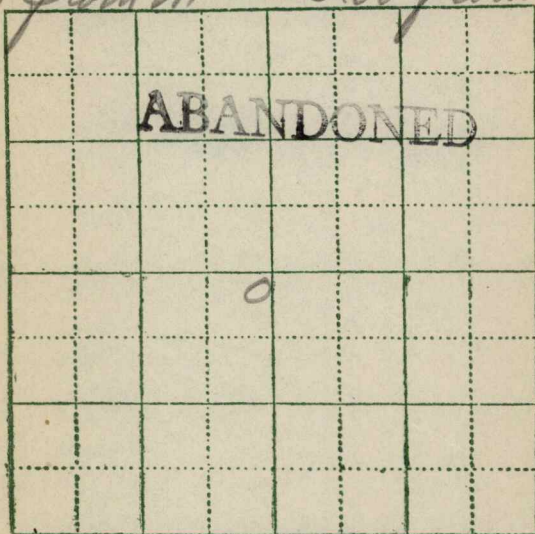

EAST

SOUTH

Location -----

Rig up -----

Drilling and Remarks:

10+92351'

RECORD

Cased ----- in., ----- ft.

Sand -----

Gas -----

Oil -----

Total Depth -----

PRODUCTION

1st 24 hrs. Nat. -----

1st 24 hrs. after shot -----

Gas ----- Cu. Ft.

Dry Hole -----

Abandoned -----

Date APR 2 1924**M. A. BENEAR**

192-----

Scout