


Map No. _____ Sec. 11 Twp. 25 R. 8Well No. 1 Tiechgraben Farm _____
Harwood Winter Company _____

NORTH

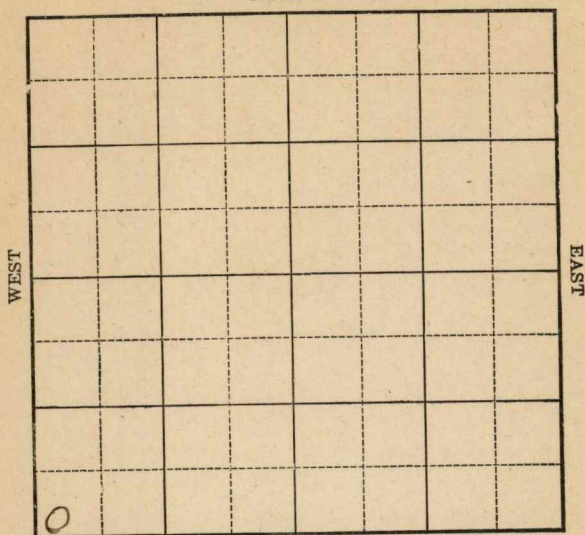

SOUTH

Location _____

Drilling Remarks:

Rig Up _____

Drilling Remarks:

RECORD

Cased _____ in. _____ ft.

Sand _____

Gas _____

Oil _____

Total Depth _____

PRODUCTION

1st 24 hrs. Nat. _____

1st 24 hrs. after shot _____

Gas _____ cu. ft.

Dry Hole _____

Abandoned _____

Map No. _____ Sec. 11 Twp. 25 R. 8


Well No. 1 Tiechgraber Farm
Harwood & Winter Company

Ft. from N. Line

Ft. from S. Line

Ft. from E. Line

Ft. from W. Line

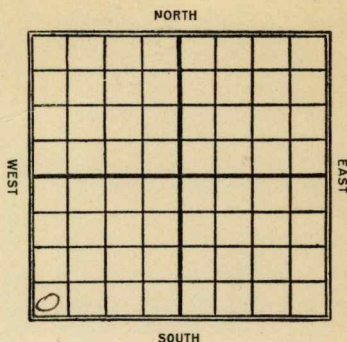

Date
1923

REPORT

4/23	Location
2/6	
4/20	Sand 2286-2340-Shot 100 qts. 30 Bbls. P.B. 2315

Map No. ¹⁵~~KANSAS~~ Sec. 11 Twp. 25 R. 8Well No. 1 TrencherHarwood & Winter Company

Contractor

FIRST REPORT

Ft. from N. Line

200 Ft. from S. Line

Ft. from E. Line

200 Ft. from W. Line

SECTION PLAT

0			

Location ✓ ✓

Rig up

Drilling and Remarks:

RECORD

Cased _____ in., _____ ft.

Sand _____

Gas _____

Oil _____

Total Depth _____

PRODUCTION

1st 24 hrs. Nat. _____

1st 24 hrs. after shot _____

Gas _____ Cu. Ft.

Dry Hole _____

Abandoned _____

Date FEB 6 1923

M. A. BENEAR

191

Scout

Map No. **KANSAS** ¹⁵ Sec. 11 Twp. 25 R. 8Well No. 1 Trachgraber
Harwood & Winters Company

Contractor

COMPLETED SECTION PLAT

Ft. from N. Line

200 Ft. from S. Line

Ft. from E. Line

200 Ft. from W. Line

Location

Rig up

Drilling and Remarks:

sand {2286'
2340'P.B. 2315'100/30 bbl**RECORD**

Cased _____ in., _____ ft.

Sand _____

Gas _____

Oil _____

Total Depth _____

PRODUCTION

1st 24 hrs. Nat. _____

1st 24 hrs. after shot _____

Gas _____ Cu. Ft.

Dry Hole _____

Abandoned _____

Date

APR 20 1923M. A. BENEAR191Scout