


Map No. K Sec. 11 Twp. 25 R. 8
Well No. 2 Lechner Farm
Plains Pit Company

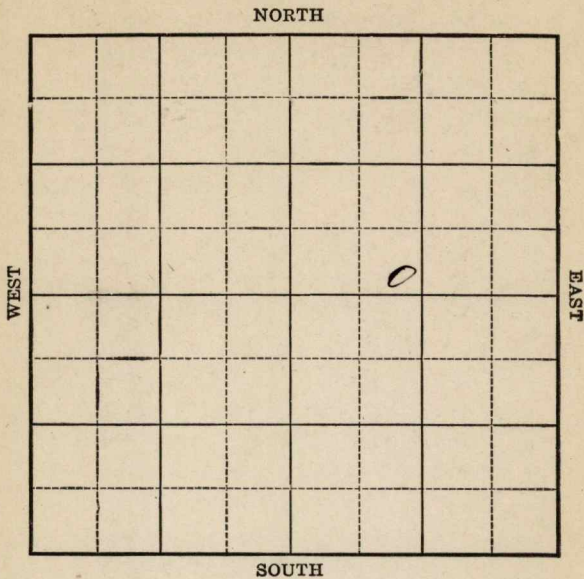

Location _____

Drilling Remarks:

RECORD

Cased _____ in. _____ ft.

Sand _____

Gas _____

Oil _____

Total Depth _____

Rig Up _____

Drilling Remarks:

PRODUCTION

1st 24 hrs. Nat. _____

1st 24 hrs. after shot _____

Gas _____ cu. ft.

Dry Hole _____


Abandoned _____

Map No. 11 Sec. 11 Twp. 25 R. 8Well No. 2 Truckee Farm
Plains Petroleum Company

Ft. from N. Line

200 Ft. from S. Line

Ft. from E. Line

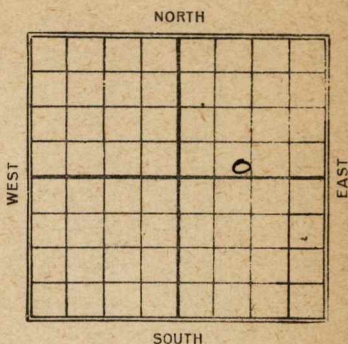1120 Ft. from W. Line

Date

REPORT

19214/2 Reg up4/24 Slg @ 900'6/18 2260-63 - showdel 2282-2305 -74 - 231760725 Bbls

Map No. KANSAS 15 Sec. 11 Twp. 25 R. 8

Well No. 2 Tiechgraber

Plains P&T Company

Contractor

FIRST REPORT

SECTION PLAT

_____ Ft. from N. Line

200 Ft. from S. Line

_____ Ft. from E. Line

1120 Ft. from W. Line

		0	

Location _____

Rig up ✓✓

Drilling and Remarks:

RECORD

Cased _____ in., _____ ft.

Sand _____

Gas _____

Oil _____

Total Depth _____

PRODUCTION

1st 24 hrs. Nat. _____

1st 24 hrs. after shot _____

Gas _____ Cu. Ft.

Dry Hole _____

Abandoned _____

Date APR 2 1924

M. A. BENEAR

_____ 192_____

_____ Scout

15 **KANSAS** Sec. 11 Twp. 25 R. 8

Well No. 2 - Telegrapher

P. Lains P. L. Company

Contractor

COMPLETED

SECTION PLAT

_____ Ft. from N. Line

200 _____ Ft. from S. Line

_____ Ft. from E. Line

1120 _____ Ft. from W. Line

Location _____

Rig up _____

Drilling and Remarks:

RECORD

Cased _____ in., _____ ft.

Sand _____

Gas _____

Oil _____

Total Depth _____

PRODUCTION

1st 24 hrs. Nat. _____

1st 24 hrs. after shot _____

Gas _____ Cu. Ft.

Dry Hole _____

Abandoned _____

Date

JUN 18 1924

1924

A. M. A. BENEAR

Scout