

Map No. _____ Sec. 11 Twp. 25 R. 8


Well No. 3-Teichgraeber Farm
Plains Pet Company

_____ Ft. from N. Line

990 Ft. from S. Line

_____ Ft. from E. Line

330 Ft. from W. Line

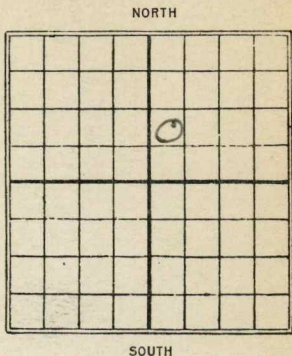

1927

Date

REPORT

7/7

Rig up

7/13

Spudding

7/20

7/28

Drilg 800

8/4

" 2160'

8/10

Sand 2395-2435-

good show oil - will shoot

8/18

2395-2435

T.D. 2435

40/25 bbls

Sherwood 8 ⁶/₁₆

15 **KANSAS** Map No. Sec. 11 Twp. 25 R. 8

Well No. 3 *Zeichgraeben*
Plains pet Co Company

Contractor

FIRST REPORTS

SECTION PLAT

----- Ft. from N. Line

990 Ft. from S. Line

----- Ft. from E. Line

330 Ft. from W. Line

		0	

Location -----

Rig up

Drilling and Remarks:

RECORD

Cased ----- in., ----- ft.

Sand -----

Gas -----

Oil -----

Total Depth -----

PRODUCTION

1st 24 hrs. Nat. -----

1st 24 hrs. after shot -----

Gas ----- Cu. Ft.

Dry Hole -----

Abandoned -----

Date *July 7* 192*7*

CHAS. L. SHERWOOD

Score

Greenwood

K15 **KANSAS** Map No. Sec. *11* Twp. *25* R. *8*

Well No. *3* *Leichgraebel*

Plains pet Co Company

Contractor

COMPLETED

SECTION PLAT

----- Ft. from N. Line

990 Ft. from S. Line

----- Ft. from E. Line

330 Ft. from W. Line

		<i>0</i>	

Location -----

Rig up -----

Drilling and Remarks:

407 25 BB.

RECORD

Cased ----- in., ----- ft.

Sand *2395-2435*

Gas -----

Oil -----

Total Depth *2435*

PRODUCTION

1st 24 hrs. Nat. -----

1st 24 hrs. after shot -----

Gas ----- Cu. Ft.

Dry Hole -----

Abandoned -----

Date

AUG 18 1927

CHAS. L. SHERWOOD

192

Scout